


# KANSAS



Section 33 Township 25S Range 13E

Well No. #1 Pitfer

Company Susmoi Oil

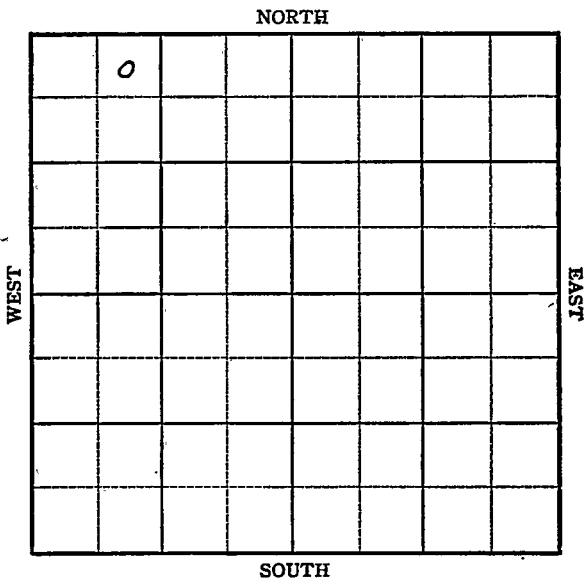

Greenwood **KANSAS**

Sec. 33 Twp. 25 R. 13E

Well No. #1 Pitfer Farm \_\_\_\_\_

Susnio Company \_\_\_\_\_


Miscellaneous (Ainsworth, Cont.)

330' Ft. from N. Line

\_\_\_\_\_ Ft. from S. Line

\_\_\_\_\_ Ft. from E. Line

990' Ft. from W. Line

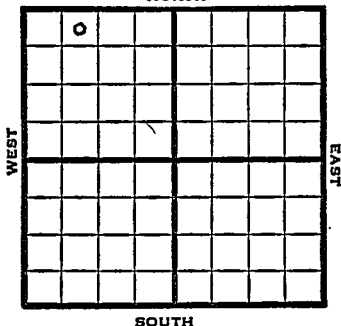

NE NW NW

1949

REPORT

9/14 8" @ 15'  
Drlg. 700'

9/21 Miss 1532'  
Drlg. 1560'

9/28 TD 1566'  
5" @ 1544'

10/5 SD

10/12 TD 1575'  
Miss 1532'  
Aband.

**ABANDONED**

Map No. \_\_\_\_\_ Sec. 33 Twp. 25 R. 13EWell No. 1 Pitfer

Susmio \_\_\_\_\_ Company

Ainsworth \_\_\_\_\_ Contractor

NE NW NW

## SECTION PLAT

330 Ft. from N. Line

\_\_\_\_\_ Ft. from S. Line

\_\_\_\_\_ Ft. from E. Line

990 Ft. from W. Line

o			

Greenwood County

## RECORD

Location \_\_\_\_\_

Cased \_\_\_\_\_ in., \_\_\_\_\_ ft.

Rig up \_\_\_\_\_

Sand \_\_\_\_\_

Drilling and Remarks:

Gas \_\_\_\_\_

8" @ 15

Oil \_\_\_\_\_

drlg. 700

Total Depth \_\_\_\_\_

## PRODUCTION

1st 24 hrs. Nat. \_\_\_\_\_

1st 24 hrs. after shot \_\_\_\_\_

Gas \_\_\_\_\_ Cu. Ft.

Dry Hole \_\_\_\_\_

Abandoned \_\_\_\_\_

Date

SEP 14 1949 19S. J. LEWIS Scout

Map No. \_\_\_\_\_ Sec. 33 Twp. 25 R. 13E

Well No. 1 Pitfer

Susmic Company

**ABANDONED** Contractor

NE NW NW

SECTION PLAT

330 Ft. from N. Line

\_\_\_\_\_ Ft. from S. Line

\_\_\_\_\_ Ft. from E. Line

990 Ft. from W. Line

6			

Greenwood County

RECORD

Location \_\_\_\_\_

Cased \_\_\_\_\_ in., \_\_\_\_\_ ft.

Rig up \_\_\_\_\_

Sand \_\_\_\_\_

Drilling and Remarks:

Gas \_\_\_\_\_

*Misc 1532*

Oil \_\_\_\_\_

Total Depth 1525

PRODUCTION

1st 24 hrs. Nat. \_\_\_\_\_

1st 24 hrs. after shof \_\_\_\_\_

Gas \_\_\_\_\_ Cu. Ft.

Dry Hole \_\_\_\_\_

Abandoned \_\_\_\_\_

Date

OCT 12 1949 19

S. J. LEWIS Scout