

Sedgwick

KANSAS

13

29S

1E

SECTION _____ TOWNSHIP _____ RANGE _____

WELL NO. #1 Estep

COMPANY Shawver-Armour

NW SE SW


NORTH

N/2 N/2SW

*KGS
DML*

WEST

EAST

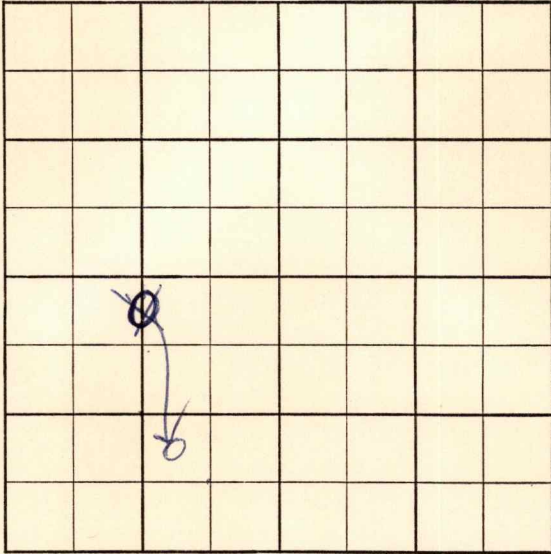

SOUTH

CORRECTION

S-513-A

CO. ~~Sedgwick~~ ELEV ~~1235~~
SEC. ~~13~~ TWP. ~~29~~ RGE. ~~1E~~
COMPANY ~~Shawver-Armour~~ NO. ~~1~~

ABANDONED
NOV 20 1937

FARM ~~Estep~~

K65/DML

LOC. ~~1/2 N 1/2 SW~~ NW SE SW

GEOL. _____
CONTR. Co. Tools #1
POOL Wildcat
SPUD 10-25-57

8" @ 156 w/85, Stal^{sd} 2287, KC 2589 Drlg. 269
NOV 5 1937 ST 01 L. 2284 BKC 2810
C 3059 M 3100 DST 3099
-3112 1 1/4 hrs 6' 0 CM BHP
150 - 90/30" FP 15-25 MLI
3122 S 3494 DST 3493
-3500 45" 6' M BHP 20-38/20"
Ø 3554 5" 3170/55 6/3102
-03 12/3106-08 1/2 24/3110-14 1/2

Ø M + oil 250 A H 190
Ø h nw NOV 20 1937 frac 3X
Ø 1/2 B O Ø h 2 B W Ø h

D to A

. TD 3554

CO.
LSE.
NO.
SEC.
TWP.
RGE.

~~29~~

WILDCAT

S-513-A

CO. Sedgwick ELEV. _____
 SEC. 13 TWP. 29 RGE. 1E
 COMPANY Shawver-Armour NO. 1

FIRST REPORT
OCT 30 57

FARM Estep
 LOC. N/2-N/2 SW - NE 56 SW - KCS/DML

GEOL. _____
 CONTR. Co. Tools #1
 POOL Wildcat
 SPUD 10-25-57

8" @ 156 w/85, Stal 2287, KC 2589 Drlg. 2692

CO.
NO.
SEC.
TWP.
RGE.