


Section 5 Township 29 Range 1 E

Well No. # 1 Ems

Company Francis Raymond

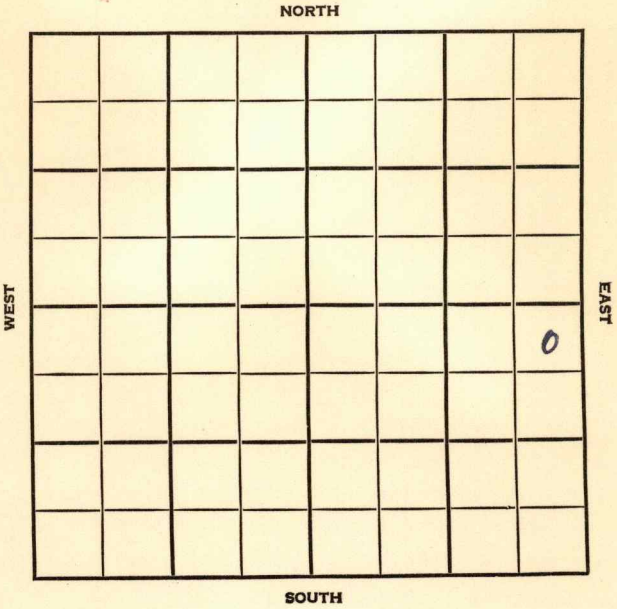

Sedgwick

KANSAS

SEC. 5	TWP. 29	R. 1 E
-----------	------------	-----------

WELL NO.

1 Ems

FARM

COMPANY

Francis Raymond

CONTRACTOR


Murfin
Gladys

_____ Ft. from N. Line

_____ Ft. from S. Line

_____ Ft. from E. Line

_____ Ft. from W. Line

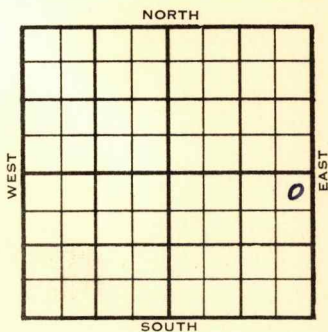

NE NE SE

	ELEVATION	REPORT
1955	1262'	

6/8
Comm. 6-5-55
8" @ 160

6/15
Drlg. 1750'
8" @ 160 D & A

Stal. 2350', KC 2686', C. 3188'
M. Lm 3200'
TD 3251' D & A

ABANDONED

County Sedgwick Elev. 1262
 Sec. 5 Twp. 29 Rge. 1E
 Company Francis Raymond
 Farm Name Ems No. 1

TOPS	DEPTH	LOG	DATUM
Anh.			
Tp.			
H.			
Tr.			
Dg.			
Bl.			
L.			
K.C.			
B.K.C.			
Ce.			
C.			
M.			
M.			
K.			
Mz.			
Me.			
V.			
S.			
S.			
A			
R.			
Pe.			
G.			
T.D.			

Loc. in Sec. NE NE SE

Geol. _____

Contr. Murfin

Pool Gladys

FIRST REPORT
 JUN 8 '55

Date Comm. 6-5-55
8" @ 160 drlg. 1750

Co.

Lse.

No.

Sec.

T.

R.

County Sedgwick Elev. 1262
 Sec. 5 Twp. 29 Rge. 1E
 Company Francis Raymond
 Farm Name Ems No. 1

TOPS	DEPTH	LOG	DATUM	Loc. in Sec.
Anh.				
Tp. <u>stal</u>	<u>2350</u>		<u>1088</u>	<u>NE NE SE</u>
H.				
Tr.				
Dg.				
Bl.				
L.				
K.C.	<u>2686</u>		<u>1424</u>	Geol. _____
B.K.C.				Contr. _____
Ce.				
C.	<u>3188</u>		<u>1926</u>	<u>Murfin</u>
M.	<u>3200</u>		<u>1938</u>	
M.				Pool _____
K.				<u>Gladys</u>
Mz.				
Me.				
V.				
S.				
S.				
A.				
R.				
Pe.				
G.				
T.D.	<u>3251</u>			



Date Comm. JUN 15 1955
8" @ 160

D & A

Co.
Lse.
No.
Sec.
T.
R.