


DX 78-1

Section 5 Township 29 S Range 1 E

Well No. #1 Hugerford Unit

Company O. A. Sutton

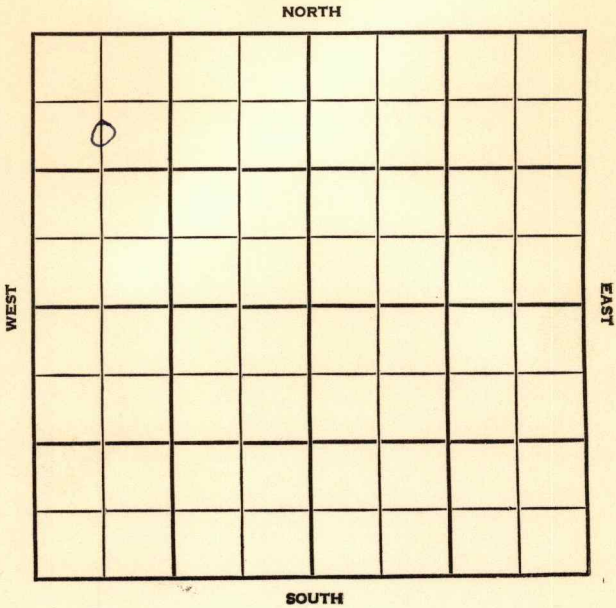

Sedgwick

KANSAS

| | | |
|------|------|----|
| SEC. | TWP. | R. |
| 5 | 29S | 1E |

WELL NO. #1 Hugerford Unit FARM

COMPANY O. A. Sutton

CONTRACTOR Gabbert-Jones


1030' Gladys Ft. from N. Line

Ft. from S. Line

Ft. from E. Line

Ft. from W. Line

C S/2 NW NW ~~1030' 8n1~~

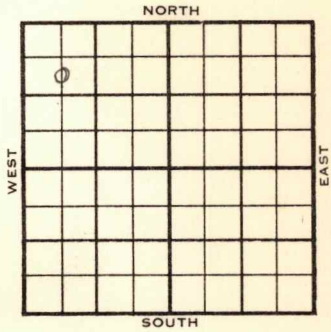

| | | |
|------|-----------|--------|
| 1955 | ELEVATION | REPORT |
| | 1267 | |

| | |
|------|------|
| 8/17 | RURT |
|------|------|

| | |
|-------|---|
| 11-23 | Comm. 8-17-55 8 5/8" @ 145/160 5 1/2" @ 3189 DD 3203, 1000 A, DD 3207 B/ 15 GO, 5 GW, 250 A S/ 81 BO 23 BW DD 3217 B/ 54 GO 36 GWPH P/ 20 BO, 10 BWPH, oil went to wtr. DD 3330' No inc. D & A Chat 3183 Dolo 3189 TD 3193' |
|-------|---|

ABANDONED

County Sedgwick Elev. _____
 Sec. 5 Twp. 29S Rge. 1E
 Company O. A. Sutton
 FarmName Hugerford Unit No. _____

| TOPS | DEPTH | LOG | DATUM |
|--------|-------|-----|-------|
| Anh. | | | |
| Tp. | | | |
| H. | | | |
| Tr. | | | |
| Dg. | | | |
| Bl. | | | |
| L. | | | |
| K.C. | | | |
| B.K.C. | | | |
| Ce. | | | |
| C. | | | |
| M. | | | |
| M. | | | |
| K. | | | |
| Mz. | | | |
| Mq. | | | |
| V. | | | |
| S. | | | |
| S. | | | |
| A. | | | |
| R. | | | |
| Pe. | | | |
| G. | | | |
| T.D. | | | |

Loc. in Sec. C S/2 NW NW
1030' fnl

Geol. _____
 Contr. Gabbert-Jones

Pool Gladys

0
 AUG 17 '55
 FIRST REPORT

Date Comm. RUNT

Co.

Lse.

No.

Sec.

T.

R.

County Sedgwick Elev. 1267
 Sec. 5 Twp. 29 Rge. 1E
 Company O. A. Sutton
 Farm Name Hugerford Unit No. 1

Co.

Lse.

No.

Sec.

T.

R.

| TOPS | DEPTH | LOG | DATUM |
|----------------|-------------|-----|-------------|
| Anh. | | | |
| Tp. | | | |
| H. | | | |
| Tr. | | | |
| Dg. | | | |
| Bl. | | | |
| L. | | | |
| K.C. | | | |
| B.K.C. | | | |
| Ce. | | | |
| C. | | | |
| M. <u>chat</u> | <u>3183</u> | | <u>1916</u> |
| M. <u>Polo</u> | <u>3189</u> | | <u>1922</u> |
| K. | | | |
| Mz. | | | |
| Mq. | | | |
| V. | | | |
| S. | | | |
| S. | | | |
| A. | | | |
| R. | | | |
| Pe. | | | |
| G. | | | |
| T.D. | <u>3193</u> | | |

Loc. in Sec. C S¹/₂ NW NW
1030' NL
 Geol. _____
 Contr. Gabbert-Jones

Pool Gladys



Date Comm. 8-17-55 NOV 23 1955

8 5/8" @ 145/160 5 1/2" @ 3189 DD 3203
1000 A DD 3207 B/ 15 go 5 gw
250 A S/ 81 bo 23 bw DD 3217
B/ 54 go 36 gwph P/ 2 0 bo 10 bwph
oil went to wtr. DD 3330 no inc.

D & A