

Sedgwick

KANSAS

SEC. 5	TWP. 29S	R. 1E
-----------	-------------	----------

WELL NO.
#1 Teneych FARM

COMPANY
E. H. Adair Oil Co.

CONTRACTOR
Rig #2


Gladys So.
2120 Ft. from N. Line

_____ Ft. from S. Line

_____ Ft. from E. Line

600 Ft. from W. Line

C S/3 SW NW

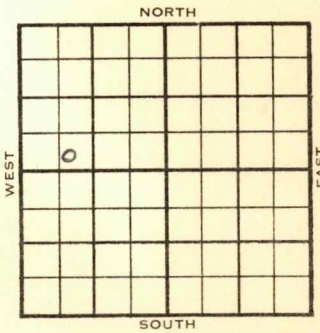

FIRST REPORT

	ELEVATION	REPORT
1955	1262'	
7/13		Spud 7/9/55 8" 189 w/135 SD for Repairs
11/9		Comm 7-9-55 8" @ 189/135 5 1/2" @ 3215/50 KC 2662 BKC 2871 Ch 3208 DoLo 3215 TD 3215 3225 CO to 3225 500 A frac S/6 bfph 85% wtr Comp 50 bopd 150 bw

COMPLETED

County Sedgwick Elev. _____
 Sec. 5 Twp. 29S Rge. 1E
 Company E. H. Adair Oil Co.
 Farm Name Teneych No. 1

TOPS	DEPTH	LOG	DATUM	Loc. in Sec.																														
Anh.				C S/2 SW NW 600' FWL x 2120' FNL NW/4 Geol. _____ Contr. <u>Ring</u> <u>Rig #2</u> Pool <u>Gladys So.</u>																														
Tp.																																		
H.																																		
Tr.																																		
Dg.																																		
Bl.																																		
L.																																		
K.C.																																		
B.K.C.																																		
Ce.																																		
C.				<table border="1"> <tr> <td></td> <td></td> <td></td> </tr> <tr> <td></td> <td></td> <td></td> </tr> <tr> <td></td> <td></td> <td></td> </tr> <tr> <td></td> <td></td> <td></td> </tr> <tr> <td></td> <td></td> <td></td> </tr> <tr> <td></td> <td></td> <td></td> </tr> <tr> <td></td> <td></td> <td></td> </tr> <tr> <td></td> <td></td> <td></td> </tr> <tr> <td></td> <td></td> <td></td> </tr> <tr> <td></td> <td></td> <td></td> </tr> </table>																														
M.																																		
M.																																		
K.																																		
Mz.																																		
Mq.																																		
V.																																		
S.																																		
S.																																		
A.																																		
R.																																		
PE.																																		
G.																																		
T.D.																																		

JUL 13 55
 FIRST REPORT

Date Comm. Spd 7/9/55 8" 189 w/135 SD for
repairs

Co.
Lsc.
No.
Sec.
T.
R.

County Sedgwick Elev. 1262
 Sec. 5 Twp. 29 Rge. 1E
 Company E. H. Adair
 Farm Name Teneych No. 1

TOPS	DEPTH	LOG	DATUM
Anh.			
Tp.			
H.			
Tr.			
Dg.			
Bl.			
L.			
K.C.	<u>2662</u>		<u>1400</u>
B.K.C.	<u>2871</u>		<u>1609</u>
Ce.			
C.			
M.	<u>ch 3208</u>		<u>1946</u>
M.	<u>dolo 3215</u>		<u>1953</u>
K.			
Mz.			
Mq.			
V.			
S.			
S.			
A.			
R.			
Pe.			
G.			
T.D.	<u>3225</u>		

Loc. in Sec. C S¹/₂ SW NW
2120' NL
600' WL
 Geol. _____
 Contr. _____
 Pool S. Gladys

0

COMPLETE

Date Comm. 7-9-55 NOV 9 1955
8" @ 189/135 5¹/₂" @ 3215/50
CO to 3225 500 A frac S/ 6 bfph
85% wtr. Comp. 50 bopd 150 bw

Co. Lse. No. Sec. T. R.