

DX 78-1

Sedgwick

KANSAS

Section 9 Township 29 Range 1E

Well No. #1 Kirby

Company Greenland Drlg. & Petroleum Inc.

NORTH

WEST

EAST

		0					

SOUTH

Sedgwick

KANSAS

SEC.	TWP.	R.
9	29	1E

WELL NO.

1 Kirby

FARM

COMPANY

Greenland Drlg & Petroleum Inc.

CONTRACTOR

Greenland

Wildcat


330' Ft. from N. Line

Ft. from S. Line

990' Ft. from E. Line

Ft. from W. Line

NW NE NW

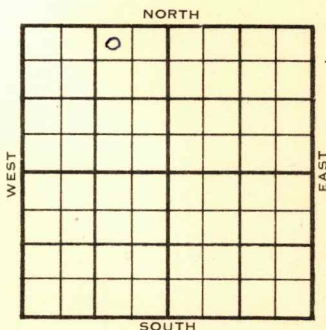

1955

ELEVATION

REPORT

6/1 Spud 5-26-55
8" @ 162 w/185
KC 2688
Drlg 2865

6/8 D&A

Tops:	Depth	Datum
2688C.	2688	1429
M ch.	3225	1966
M dolo	3242-	1983
TD.	3265	


ABANDONED

County Sedgwick State Kansas
 Sec. 9 - (Blk.) 29 (Sur.) 1E Map No.
 Operator Greenland Drlg. & Petroleum Inc.
 Well No. 1 Farm Kirby
 Elev. _____ Location NW NE NW



330 Ft. From N Line NW
990 Ft. From E Line Quarter
 1st. Report JUN 1 1955
 Completion _____
 Remarks CRA farmout
Greenland - Contr.
 Spudding Date 5-26-55

Drlg. Data Wildcat
8" @ 162 w/ 185 KC 2688 drlg. 2865

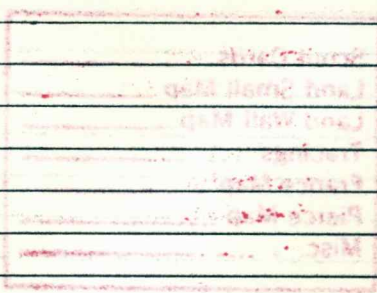

County Sedgwick Elev. 1259
 Sec. 9 Twp. 29 Rgs. 1E
 Company Greenland Drlg. & Petroleum Inc.
 Farm Name Kirby No. 1

TOPS	DEPTH	LOG	DATUM	Loc. in Sec.
Anh.				NW NE NW
TP.				
H.				
Tr.				
Dg.				
BL.				
L.				
K.C.	2688		1429	Geol.
B.K.C.				Contr.
Ce.				Greenland
C.				
M. <u>ch</u>	3225		1966	Pool
M. <u>Dolo</u>	3242		1983	
K.				Wildcat
Mz.				
Mq.				
V.				
S.				
S.				
A.				
R.				
PE.				
G.				
T.D.	3265			

Date Comm. 5-26-55

8" @ 162

D & A