


KANSAS

Map No. \_\_\_\_\_ Sec. 34 Twp. 25 R. 13Well No. 1-Geise FarmMcCullough Company

NORTH

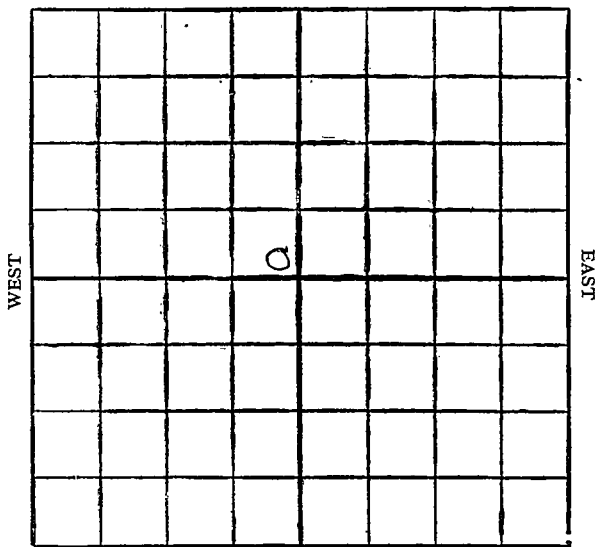

SOUTH

Location .....

Drilling Remarks

.....

.....

## RECORD

Cased ..... in. .... ft.

Sand .....

Gas .....

Oil .....

Total Depth .....

Rig Up .....

Drilling Remarks

.....

.....

## PRODUCTION

1st 24 hrs. Nat. ....

1st 24 hrs. after shot .....

Gas ..... cu. ft.

Dry Hole .....

Abandoned .....

Map No. KANSAS Sec. 34 Twp. 25 R. 13Well No. 1-Beisse FarmMcCullough Oil Company

NORTH

\_\_\_\_\_ Ft. from N. Line

250 Ft. from S. Line250 Ft. from E. Line

\_\_\_\_\_ Ft. from W. Line

WEST

EAST

SOUTH

1928

Date

REPORT

5/17, Hrlg 600'5/24 Topline 1474Net A. 1517'

*to J. M. Wood*  
KANSAS

MAP NO. 34 SEC. 25 TWP. 13 R. 13

WELL NO. 1 *Gliss*

*McCullough Oil Co* COMPANY

CONTRACTOR

# FIRST REPORTS

## SECTION PLAT

|  |  |  |  |
|--|--|--|--|
|  |  |  |  |
|  |  |  |  |
|  |  |  |  |
|  |  |  |  |
|  |  |  |  |

FT. FROM N. LINE

*750*

FT. FROM S. LINE

*750*

FT. FROM E. LINE

FT. FROM W. LINE

## RECORD

LOCATION \_\_\_\_\_

CASED \_\_\_\_\_ IN. \_\_\_\_\_ FT.

RIG UP \_\_\_\_\_

SAND \_\_\_\_\_

DRILLING AND REMARKS:

GAS \_\_\_\_\_

OIL \_\_\_\_\_

TOTAL DEPTH \_\_\_\_\_

## PRODUCTION

1ST 24 HRS. NAT. \_\_\_\_\_

1ST 24 HRS. AFTER SHOT \_\_\_\_\_

GAS \_\_\_\_\_ CU. FT.

DRY HOLE \_\_\_\_\_

ABANDONED \_\_\_\_\_

DATE *May 17* 1928

CHAS. L. SHERWOOD

SCOUT

*to Murrells*  
 KANSAS  
 MAP NO. 34 SEC. 25 TWP. 13  
 WELL NO. 1 *Seise*  
McCullough DDG COMPANY

CONTRACTOR

COMPLETED

SECTION PLAT

|  |   |  |  |
|--|---|--|--|
|  |   |  |  |
|  |   |  |  |
|  | 0 |  |  |
|  |   |  |  |
|  |   |  |  |

Ft. FROM N. LINE

250

Ft. FROM S. LINE

250

Ft. FROM E. LINE

Ft. FROM W. LINE

ABANDONED

RECORD

LOCATION \_\_\_\_\_

CASED \_\_\_\_\_ IN. \_\_\_\_\_ FT.

RIG UP \_\_\_\_\_

SAND \_\_\_\_\_

DRILLING AND REMARKS:

GAS \_\_\_\_\_

OIL \_\_\_\_\_

TOTAL DEPTH 1517

PRODUCTION

1ST 24 HRS. NAT. \_\_\_\_\_

1ST 24 HRS. AFTER SHOT \_\_\_\_\_

GAS \_\_\_\_\_ CU. FT.

DRY HOLE ☒ABANDONED ☒

DATE

MAY 24 1928 CHAS. L. SHERWOOD

192

SCOUT