




Section 36 Township 25 Range 13-E

Well Number 1-Timm

Company Foster et al

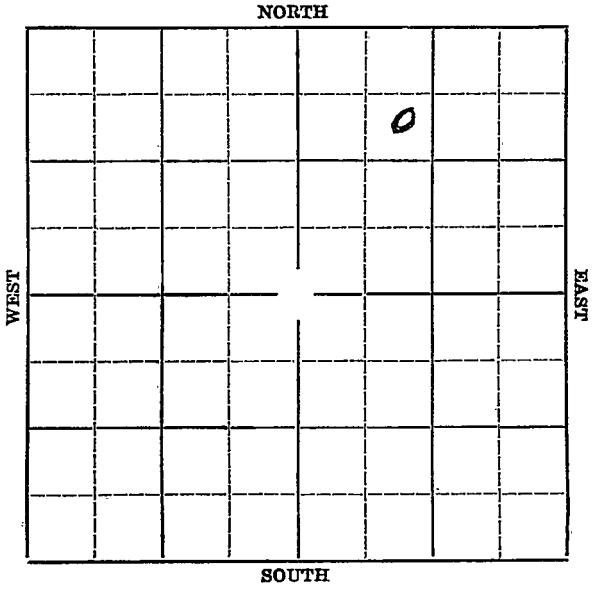

Map No. **KANSAS** Sec. **36** Twp. **25** R. **13-E**


Well No. **1-Timm** Farm  
**Foster et al** Company

990 Ft. from N. Line

\_\_\_\_\_ Ft. from S. Line

\_\_\_\_\_ Ft. from E. Line

990 Ft. from W. Line

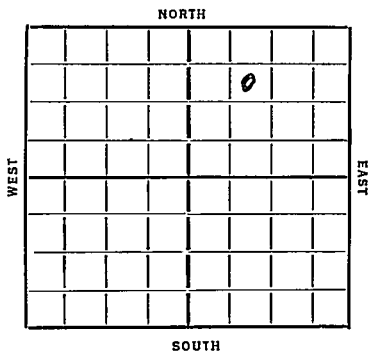

Date	REPORT
1936	
4/22	Spud
4/30	Dr lg. 425'.
5/7	S.O. 602-07'.
5/14	Shut down.
5/21	--
5/28	Bart. sand. 1426'. Run 5" 1420'.
6/4	1465' S.D.
6/11	--
6/24/36	-Miss. Lime. 1520'.
	T.D. 1520'.
	D & A <b>ABANDONED</b>

Map No. 17 Sec. 36 Twp. 25 R. 13EWell No. 1 TimmerFoster & Co. Company

Contractor

## SECTION PLAT

		0	

990 Ft. from N. Line

..... Ft. from S. Line

..... Ft. from E. Line

990 Ft. from W. Line

## FIRST REPORT

Location.....

Rig up.....

Drilling and Remarks:

*Spud.*

## RECORD

Cased..... in., ..... ft.

Sand.....

Gas.....

Oil.....

Total Depth.....

## PRODUCTION

1st 24 hrs. Nat.....

1st 24 hrs. after shot.....

Gas..... Cu. Ft.

Dry Hole.....

Abandoned.....

Date

APR 22 1936

192

J. LEWIS

Scout

Map No. 17 Sec. 36 Twp. 25 R. 13EWell No. 1 TimmerFoster & Co Company

Contractor

## SECTION PLAT

$\frac{0.5}{12}$		0	

990 Ft. from N. Line

\_\_\_\_\_ Ft. from S. Line

\_\_\_\_\_ Ft. from E. Line

990 Ft. from W. Line

ABANDONED

Location \_\_\_\_\_

Rig up \_\_\_\_\_

Drilling and Remarks:

Miss L 1520J & H

## RECORD

Cased \_\_\_\_\_ in.; \_\_\_\_\_ ft.

Sand \_\_\_\_\_

Gas \_\_\_\_\_

Oil \_\_\_\_\_

Total Depth: 1520

## PRODUCTION

1st 24 hrs. Nat. \_\_\_\_\_

1st 24 hrs. after shot \_\_\_\_\_

Gas \_\_\_\_\_ Cu. Ft.

Dry Hole \_\_\_\_\_

Abandoned \_\_\_\_\_

Date

JUN 24 1936 19

S. J. LEWIS Scout