


Section 17 Township 29 S Range 1 E

Well No. #1 Senoe

Company Adair Oil Co.

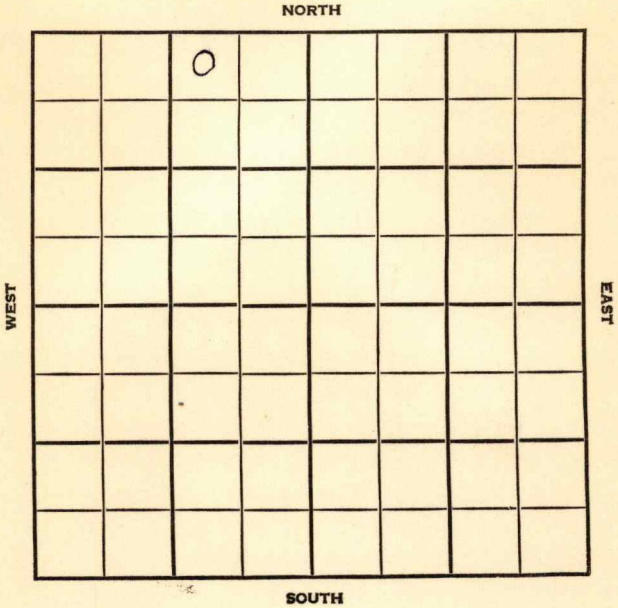

Sedgwick

KANSAS

SEC.

17

TWP.

29S

R.

1E

WELL NO.

#1 Sence

FARM

COMPANY

Adair Oil Co.

CONTRACTOR

Co. Tools

Wildcat


Ft. from N. Line

Ft. from S. Line

Ft. from E. Line

Ft. from W. Line

N W NE NW

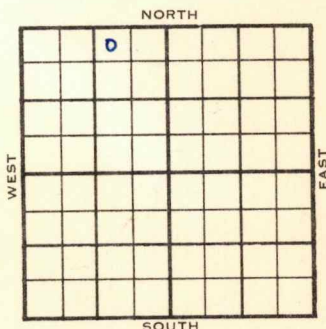

1955

ELEVATION

1256'

REPORT

9/28

HURT

10/12

Comm. 10-2-55
8-5/8" @ 164/140
TD 3340' D & A

Tops: L. 2431', Stal 2438', KC 2755'
M. Chert 3294', MLm 3300'

ABANDONED

County Seligwick Elev. _____
 Sec. 17 Twp. 29S Rge. 1E
 Company Adair Oil Co.
 Farm Name Sence No. 1

TOPS	DEPTH	LOG	DATUM	Loc. in Sec.
Anh.				NW NE NW
TP.				
H.				
Tr.				
Dg.				
BL.				
L.				Geol.
K.C.				Contr.
B.K.C.				Co. tools
Ce.				Pool
C.				Wildcat
M.				
M.				
K.				
Mz.				
Mq.				
V.				
S.				
S.				
A.				
R.				
PE.				
G.				
T.D.				

Date Comm. RIET SEP 28 1955

County Sedgwick Elev. 1256Sec. 17 Twp. 29 Rge. 1ECompany Adair OilFarm Name Sence No. 1

TOPS

DEPTH

LOG

DATUM

Loc. in Sec.

Anh.

Tp.

H.

Tr.

Dg.

BL.

L.

K.C.

S.K.C.

Ce.

C.

M.

M.

K.

Mz.

Mq.

V.

S.

S.

A.

R.

Pc.

G.

T.D.

2431

2438

2755

3294

3300

3340

1175

1182

1499

2038

2044

Geol.

Contr.

Co. tools

Pool

Wildcat

	o	x

ABANDONED

Date Comm. 10-2-55

OCT 1 2 1955

8 5/8" @ 164/140

D & A

Check spot & description. Do not agree.
Advise.

Mickey
Scouting Dept.

Scout Cards *mm*
Land Small Map.....
Land Wall Map.....
Tracings.....
France Map.....
Pierce Map.....
Misc.

OCT 27 1955