
Sedgwick KANSAS

SECTION 18 TOWNSHIP 29S RANGE 1E

WELL NO. #1 Roger

COMPANY Shawver - Armour

NORTH SW SW NE

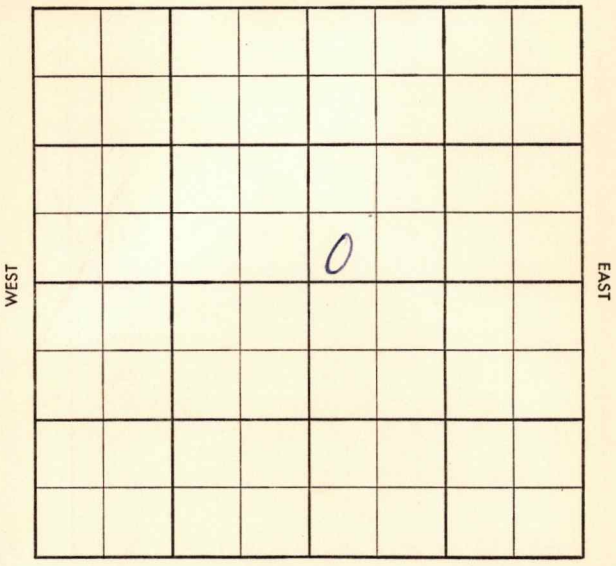

FORM 504-3 SUNRAY

S-513-A

CO. Sedgwick ELEV. 1294 KB / 1291 DF

SEC. 18 TWP. 29 RGE. 1E

COMPANY Shawver-Armour NO. 1

ABANDONED

JAN 22 '58

FARM Rover

LOC. SW SW NE

Stl 2432

kc 2759

M 3373

TD 3423

GEOL.

CONTR. Co. Tools #1

POOL Semi WC (Brumley)

SPUD 1/4/58

8" @ 270 w/225, Drlg. 1410.

no log JAN 22 '58

D&A

CO. LSE. NO. SEC. TWP. RGE.

29

S-513-A

CO. Sedgwick ELEV.

SEC. 18 TWP. 29 RGE. 1E

COMPANY Shawver-Armour NO. 1

JAN 8 '58

FIRST REPORT

FARM Roger

LOC. SW SW NE

GEOL.

CONTR. Co. Tools #1

POOL Semi WC (Brumley)

SPUD 1/4/58

8" @ 270 w/225, Drlg. 1410.

CO. LSE. NO. SEC. TWP. RGE.