
DX 78-1 Sedgwick

KANSAS

Section 18 Township 29 Range 1E

Well No. 1 Royer

Company Petroleum Inc.

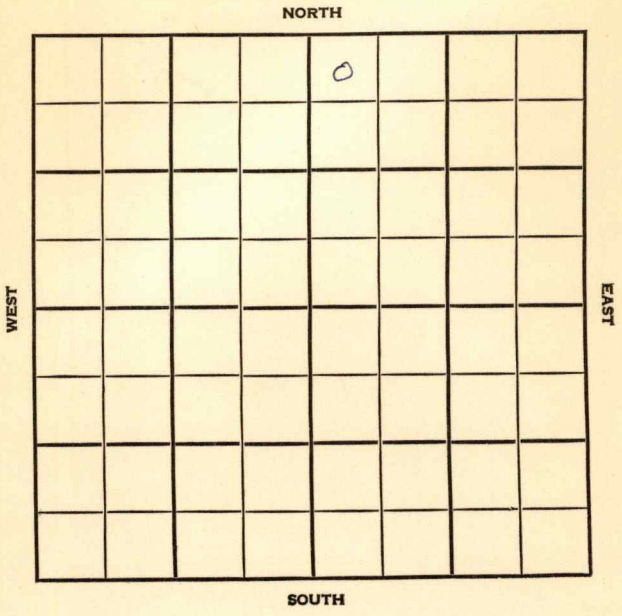

Sedgwick KANSAS

SEC.	TWP.	R.
18	29	1 E

WELL NO.

1 Royer FARM

COMPANY

Petroleum Inc.

CONTRACTOR

Garvey

Wildcat


330 Ft. from N. Line

Ft. from S. Line

Ft. from E. Line

330 Ft. from W. Line

NW NW NE

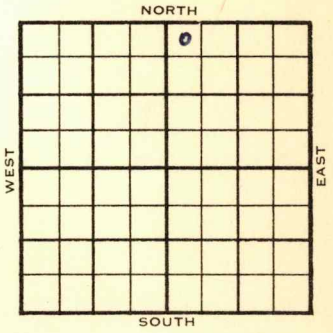

1955	ELEVATION 1293'	REPORT
4/27	Spud 4-20-55 8" @ 186 Drlg. 2746'	

DX-78

FORM 275 FOR SALE BY KANSAS BLUE PRINT CO.


County Sedgwick State Kansas

Sec. 18 (Blk. / Twp.) 29 (Sur. / Rge.) 1E Map No.

Operator Petroleum Inc.

Well No. 1 Farm Royer

Elev. 1293 Location NW NW NE

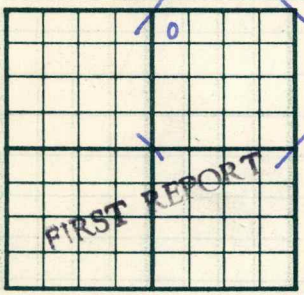

330 Ft. From N Line NE

330 Ft. From W Line Quarter

1st. Report APR 27 1955

Completion

Remarks

Garvey - Contr.

Spudding Date 4-20-55

Drlg. Data Wildcat

8" @ 186 drlg. 2746

FABEN GILSTRAP