


Section 15 Township 16 Range 12W

Well No. 3 Ehly

Company Vickers

Kraft-Prusa

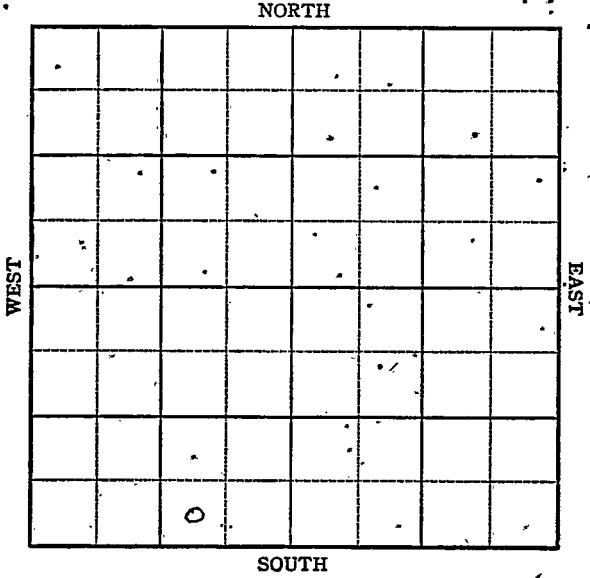

Sec. 15 Twp. 16 R. 12-W

Well No. #3 Ehly Farm


Vickers Company

 Ft. from N. Line

330 Ft. from S. Line

990 Ft. from E. Line

 Ft. from W. Line

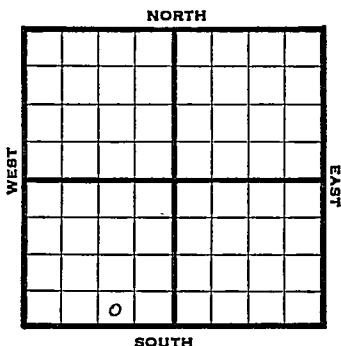

SW SE SW

1947

Elev. 1908

REPORT

4/9 Rigging up Rotary.

4/15 8" @ 502'
Drlg. 2700'

4/23 Lans 3074
Gorham 3361
Arb 3365
TD 3367'
5" @ 3363'
RUST

4/30 Arb 3365
5" @ 3363'
TD 3369'

ABANDONED

Map No. 155 Sec. 15 Twp. 16 R. 12W

Well No. 3 Ehly


Vickers Company

FIRST REPORT Contractor

SW SE SW

SECTION PLAT

_____ Ft. from N. Line
330 Ft. from S. Line
990 Ft. from E. Line
_____ Ft. from W. Line

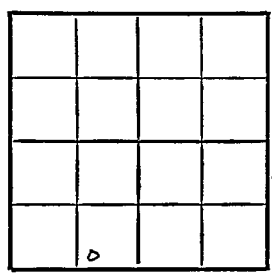

Barton County,

Location _____

Rig up _____

Drilling and Remarks:

R U R

RECORD

Cased _____ in., _____ ft.
Sand _____
Gas _____
Oil _____
Total Depth _____

PRODUCTION

1st 24 hrs. Nat. _____
1st 24 hrs. after shot _____
Gas _____ Cu. Ft.
Dry Hole _____
Abandoned _____

Date

APR 9 1947 19

S. J. LEWIS Scout

Kansas

Map No. 55 Sec. 15 Twp. 16 R. 12W

Well No. 3 Ehly

Vickers Company

ABANDONED

Contractor

SW SE SW

E. 1908

SECTION PLAT

_____ Ft. from N. Line

330 Ft. from S. Line

990 Ft. from E. Line

_____ Ft. from W. Line

Barton County

Location _____

Rig up _____

Drilling and Remarks:

Aug 23 1913
5' 10" 23 63

RECORD

Cased _____ in., _____ ft.

Sand _____

Gas _____

Oil _____

Total Depth 2369

PRODUCTION

1st 24 hrs. Nat. _____

1st 24 hrs. after shot _____

Gas _____ Cu. Ft.

Dry Hole _____

Abandoned _____

Date

APR 30 1947 19

S. J. LEWIS Scout