


LOCATION NOTICE

TULSA, OKLA., June 19th, 1924. 192

WELL No. 1 ON G. F. Fleshman FARM

WILL BE AS FOLLOWS:

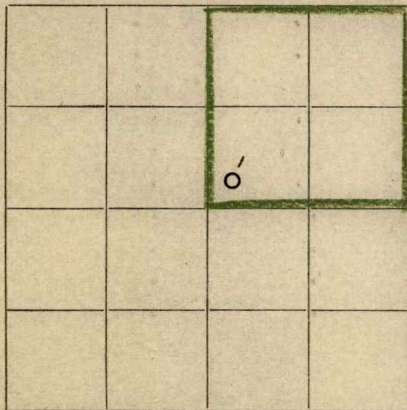

_____ FEET FROM NORTH LINE
 _____ FEET FROM EAST LINE
 _____ 300 _____ FEET FROM SOUTH LINE
 _____ 300 _____ FEET FROM WEST LINE

IN NE 1/4 SEC. 27 TWP. 29S RANGE 1E
Sedgwick COUNTY, STATE OF Kansas

REMARKS: _____

(SIGNED) *G. F. Fleshman*

COPIES TO

- DISTRICT SUPT.
- ACCOUNTING DEPT.
- RENTAL DEPT.
- SCOUTING DEPT. ✓
- FILE

Returned ✓
 Cards ✓
 Tracing ✓
 J. S. C. map ✓
 Frantz map ✓
 Moody map ✓
 Frantz plat book ✓
 Moody plat book ✓