

Sec. 27 Twp. 29 Range 1E

1 G.H. Fleshman


Kansas Geological Society

Cosden

Skelly Scout Tickets

Map No. _____ Sec. 27 Twp. 29 R. 1E
 Well No. 1. Y & H Hushman Farm
Cosden Company

_____ Ft. from N. Line
300 Ft. from S. Line
 _____ Ft. from E. Line
300 Ft. from W. Line

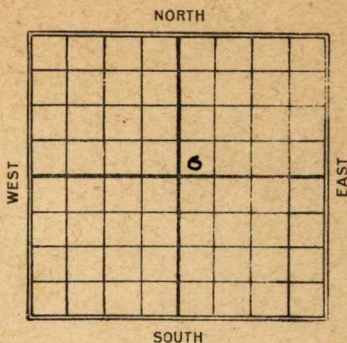

Date	REPORT
1/9/14 6/19 7/16	Location Notice
8/14	Top line @ 2530'- Reaming 8 1/4 @ 2300 to Top of line
8/20	SD. 2530'- U.R. 8 1/4 - @ 2373-
8/22	U.R. & C. @ 2435 310 2530' Superior made location and moving in material 14-29-2 1/2"
8/27	Sandy line. 2785-2805 6 lbs water per hr @ 2785- hole filling up @ 2805-
9-4	out of line. 2970'- into black slate. J.H. 2995'- getting ready to run 6 5/8 esp
10/11	Dly 3590 in Black lime (J.H.)

10/14- 3725' in Green shale
Little show oil

10/18- 3741 C. M.
1000 ft water in hole
couldn't bail it out
fast enough.

10/28- Tap Lime sand
Wilcox 3700 Alg. to
3742' N.7. W. - L.O. + A.

11/12- Wilcox 3700-41
Δ + A H.F.W.

12 **KANSAS** Map No. Sec. 27 Twp. 29 R. 1 E

Well No. #1 Fishman
Cassidy Oil Co. Company

Contractor

FIRST REPORT

SECTION PLAT

----- Ft. from N. Line
200 Ft. from S. Line
----- Ft. from E. Line
200 Ft. from W. Line

		0	

Location -----

Rig up -----

Drilling and Remarks:

Rig up

RECORD

Cased ----- in., ----- ft.
Sand -----
Gas -----
Oil -----
Total Depth -----

PRODUCTION

1st 24 hrs. Nat. -----
1st 24 hrs. after shot -----
Gas ----- Cu. Ft.
Dry Hole -----
Abandoned -----

Date JUN 24 1924

M. A. BENEAR

(12) MAP No. K12 SEC. 27 TWP. 29S R. 1E
 WELL No. 1 Shickman
Cosden COMPANY

CONTRACTOR

SECTION PLAT

*our map shows
 3812
 not changing*

_____ FT. FROM N. LINE
 _____ FT. FROM S. LINE
 _____ FT. FROM E. LINE
 _____ FT. FROM W. LINE

LOCATION _____

RIG UP _____

DRILLING AND REMARKS:

3705 } showing
 3708 } oil
 3736 } H. 2 N.
 3712 }

RECORD

CASED _____ IN. _____ FT.
 SAND _____
 GAS _____
 OIL _____
 TOTAL DEPTH 3712

PRODUCTION

1ST 24 HRS. NAT. _____
 1ST 24 HRS. AFTER SHOT _____
 GAS _____ CU. FT.
 DRY HOLE
 ABANDONED

DATE

10/21 192

SCOUT

12 **KANSAS**
Map No. _____ Sec. 27 Twp. 29 R. 1 E

Well No. 1, *F. L. Latham*
Casden & S. Company

Contractor _____

ABANDONED SECTION PLAT

_____ Ft. from N. Line

200 Ft. from S. Line

_____ Ft. from E. Line

200 Ft. from W. Line

		0	

Location _____

Rig up _____

Drilling and Remarks:

Wilcox 3700-41
2049
N.F.W.

RECORD

Cased _____ in., _____ ft.

Sand _____

Gas _____

Oil _____

Total Depth _____

PRODUCTION

1st 24 hrs. Nat. _____

1st 24 hrs. after shot _____

Gas _____ Cu. Ft.

Dry Hole _____

Abandoned _____

Date

NOV 12 1924

M. A. BENEAR

192 _____

Scout