


Section 15 Township 16 Range 12W

Well No. #3 Kramer

Company Derby Oil

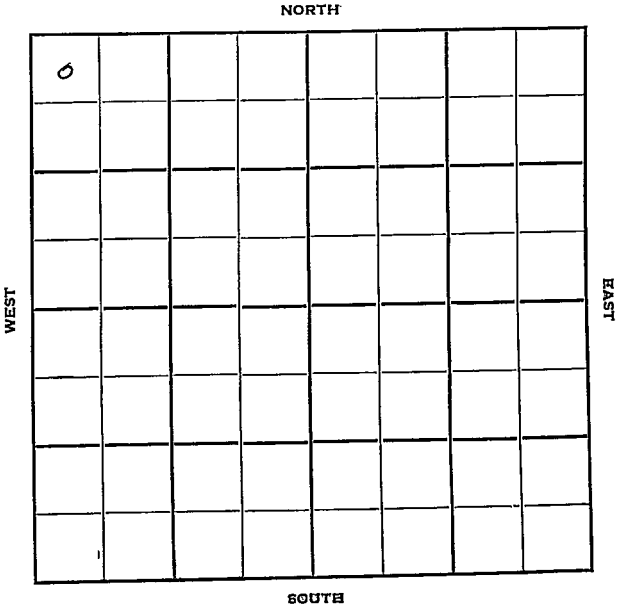

Barton KANSAS ✓

Sec. 15 Twp. 16 R. 12W

Well No. #3 Kramer Farm

Derby Oil

Company

Lauck

Contractor

Kraft-Prusa Pool


330' Ft. from N. Line

Ft. from S. Line

Ft. from E. Line

330' Ft. from W. Line

NW/C

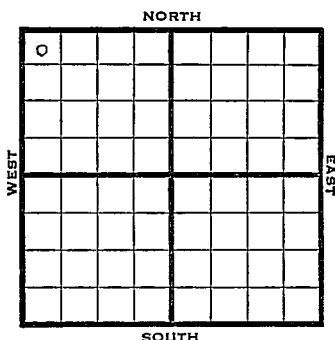

1949

REPORT

11/2	Location
11/9	8" @ 530'
	Drlg. 2310'
11/16	Lansing 3058'
	Arb. 3319-21'
	TD 3321'
	5"@ 3320'
11/23	TD 3322
	200 acid
	Swb 23/4 bbls oil PH 10 hrs.
11/29	"
12/7	"
12/14	"
12/21	"
12/28	"
1950	
1/4	TD 3322'
	8"@ 530'
	Lans 3058'
	Arb. 3319'
	5"@ 3320'
	900' oil in 9 hrs.
	200 acid
	40 shots 3058-68
	28 shots 3051-58
	1500 acid
	Pump 5' oil PH 4 hrs.
	300 acid
	Pump 80' oil 8 wtr 24 hrs.

COMPLETED

6/27/47

Kansas

Kraft-Prusa Pool

Map No. _____ Sec. 15 Twp. 16 R. 12W

Well No. 3 Kramer

Derby Oil Company

Lauck Contractor

NW/C

FIRST REPORT
SECTION PLAT

330 Ft. from N. Line

_____ Ft. from S. Line

_____ Ft. from E. Line

330 Ft. from W. Line

0			

Barton County

Location X

Rig up

Drilling and Remarks:

RECORD

Cased _____ in., _____ ft.

Sand _____

Gas _____

Oil _____

Total Depth _____

PRODUCTION

1st 24 hrs. Nat. _____

1st 24 hrs. after shot _____

Gas _____ Cu. Ft.

Dry Hole _____

Abandoned _____

Date

NOV 2 1949 19

S. J. LEWIS

Scout

Kansas


Map No. _____ Sec. 15 Twp. 16 R. 12WWell No. 3 Kramer

Derby Oil _____ Company

Contractor

NW/C

SECTION PLAT

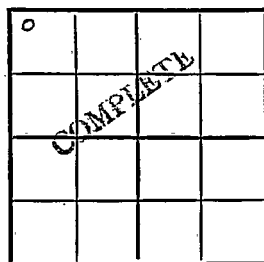330 Ft. from N. Line

_____ Ft. from S. Line

_____ Ft. from E. Line

330 Ft. from W. Line

Barton County

Location _____

Rig up _____

Drilling and Remarks:

8" @ 530Lans. 3058arb. 33195" @ 3320900' oil in 9 hrs.200 acid40 shots 3058-6828 shots 3051-581500 acidPump 5' oil 4 hrs.300 acidPump 80 oil 8 waterDate 24 hrs.

RECORD

Cased _____ in., _____ ft.

Sand _____

Gas _____

Oil _____

Total Depth 3322

PRODUCTION

1st 24 hrs. Nat. _____

1st 24 hrs. after shot _____

Gas _____ Cu. Ft.

Dry Hole _____

Abandoned _____

JAN 4 1950

19

J. E. Lura Scout