

Sec. 25 Twp. 29S Range 1E

#1 Shoemaker "A"

Kansas Geological Society

Petroleum, Inc.

Skelly Scout Tickets

Sedgwick**KANSAS**

SEC.

25

TWP.

29S

R.

1E

WELL NO.

1 Shoemaker "A"

FARM

COMPANY

Petroleum Inc.

CONTRACTOR

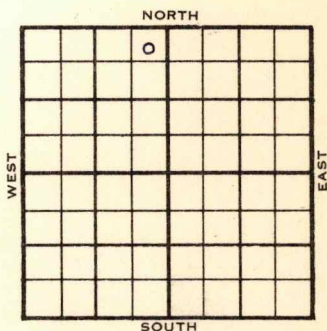
Wildcat

_____ Ft. from N. Line

_____ Ft. from S. Line

_____ Ft. from E. Line

_____ Ft. from W. Line

**NE NE NW****1955**

ELEVATION

1240'

REPORT

5/25

**KC 2606; Miss Cht 3125; Chatta 3492;
Simp 3527; Arb 3572;
TD 3590; 8 5/8" 127
DST 3125-38 open 1 hr, rec 15' socm
35#; DST 3138-83 open 1 hr rec 32'
so and gcm, 1040#; no log;
D&A**

FIRST REPORT**ABANDONED**