


Section 29 Township 29S Range 1E

Well No. 1 Mogan

Company J. P. Gaty et al

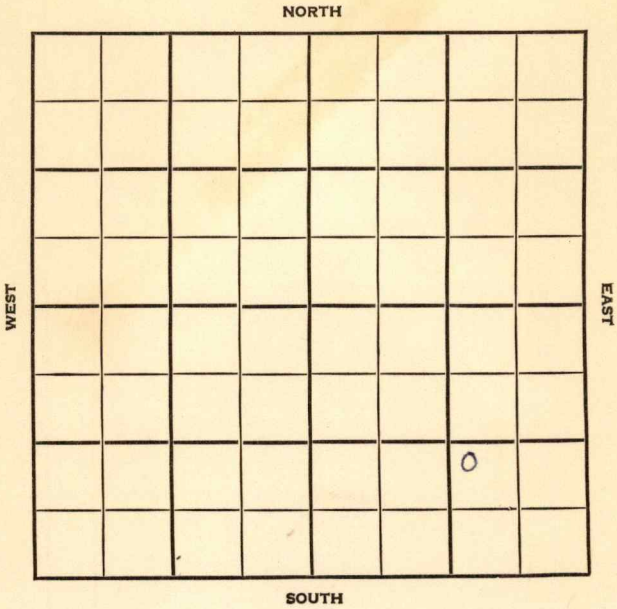

Sedgwick

KANSAS

SEC. 29	TWP. 29S	R. 1E
------------	-------------	----------

WELL NO.

#1 Mogan

FARM

COMPANY

J. P. Gaty et al

CONTRACTOR

Morrison Rig #2

W.C.


\_\_\_\_\_ Ft. from N. Line

\_\_\_\_\_ Ft. from S. Line

\_\_\_\_\_ Ft. from E. Line

\_\_\_\_\_ Ft. from W. Line

NW SE SE

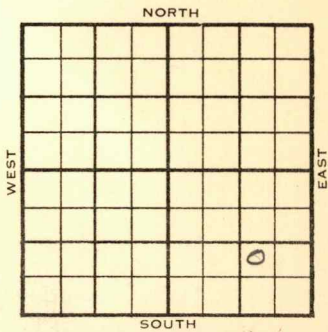

FIRST REPORT

1955	ELEVATION 1268'	REPORT
------	--------------------	--------

7/13

Spud: 7/7/55  
8" @146 w/100  
D 2808

7/20

D&A

Tops:	Depth	Datum
KC	2781	1513
Ce <sup>arm</sup>	3000	1732
C.	3328	2060
M ch.	3345	2077
M. Dolo	3354	2086

ABANDONED

County Sedgwick Elev. \_\_\_\_\_  
 Sec. 29 Twp. 29S Rgs. 1E  
 Company J. P. Gaty et al  
 Farm Name Mogan No. 1

TOPS	DEPTH	LOG	DATUM	Loc. in Sec.
Anh.				NW SE SE
Tp.				
H.				
Tr.				
Dg.				
Bl.				
L.				Geol. <u>H. Redmon</u>
K.C.				Contr. <u>Rig #2</u>
B.K.C.				<u>Morrison</u>
Ce.				Pool
C.				<u>W.C.</u>
M.				<div style="border: 1px dashed black; padding: 5px; text-align: center;">                     JUL 13 '55                      FIRST REPORT                      0                 </div>
M.				
K.				
Mz.				
Me.				
V.				
S.				
S.				
A.				
R.				
PE.				
G.				
T.D.				

Date Comm. spd 7/7/55 8" 146 w/100 D 2808

Co. Lse. No. Sec. T. R.

County Sedgwick Elev. 1268  
 Sec. 29 Twp. 29 Rgs. 1E  
 Company J. P. Gaty etal.  
 Farm Name Mogan No. 1

TOPS	DEPTH	LOG	DATUM
Anh.			
Tp.			
H.			
Tr.			
Dg.			
Bl.			
L.			
K.C.	<u>2781</u>		<u>1513</u>
B.K.C.			
Ce. <u>Marm</u>	<u>3000</u>		<u>1732</u>
C.	<u>3328</u>		<u>2060</u>
M. <u>ch</u>	<u>3345</u>		<u>2077</u>
M. <u>DoTo</u>	<u>3354</u>		<u>2087</u>
K.			
Mz.			
Ma.			
V.			
S.			
S.			
A.			
R.			
Pe.			
G.			
T.D.			

Loc. in Sec. NW SE SE

Geol. \_\_\_\_\_

Contr. Morrison

Pool Wildcat



Date Comm. 7-7-55

JUL 20 1955

8" @ 146/100

D & A

Co.  
Lse.  
No.  
Sec.  
T.  
R.