

Sedgwick KANSAS

Section 30 Township 29 Range 1 EWell No. # 1 CallowayCompany Trans-Era et al

					0		

NORTH

WEST

EAST

SOUTH

Sedgwick

KANSAS ✓

Sec. 30 Twp. 29 R. 1EWell No. #1 Calloway FarmTrans-Era et al CompanyTrans-Era ContractorWildcat990

Ft. from N. Line

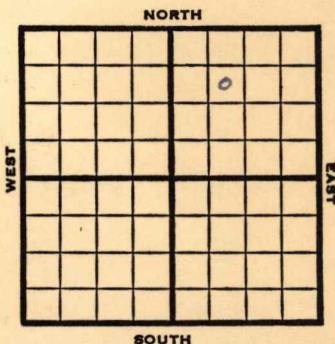
Ft. from S. Line

Ft. from E. Line

990

Ft. from W. Line

SE NW NE

1953Elev. 1276'

REPORT

8/26

M I R

9/30

Spud 8-27-53

D & A

TD 3854'

8" @ 166'

Stal. 2432, KC 2766, Kh 3718, Simp 3772DST 3791-98 opn $\frac{1}{2}$ hr, rec 4' mud 30#Arb 3838

TD 3854'

D & A

ABANDONED

D & A