


Woodson

Map No. Kansas Sec. 9 Twp. 25 R. 14
 Well No. 1 Stephenson Farm
Prairie O. & G. Company

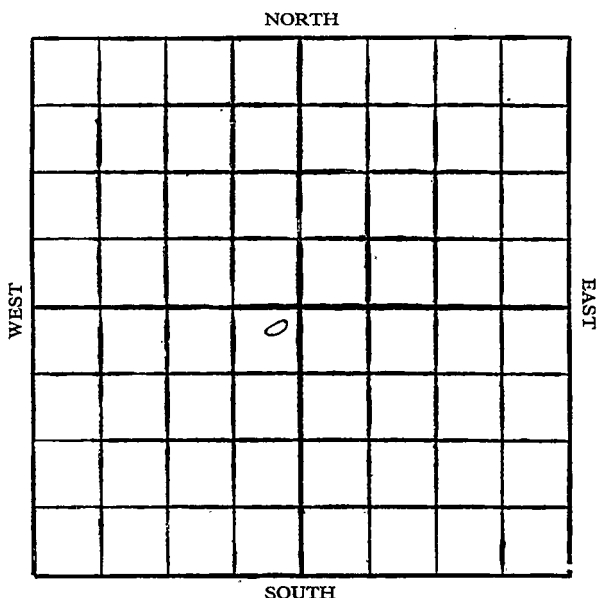

Location

Drilling Remarks

Rig Up.....

Drilling Remarks

RECORD

Cased.....in.ft.

Sand

Gas

Oil

Total Depth.....

PRODUCTION

1st 24 hrs. Nat.....

1st 24 hrs. after shot.....

Gas..... cu. ft.

Dry Hole.....

Abandoned.....

woodson

Map No. _____ Sec. 9 Twp. 25 R. 14Well No. 1 - Stephenson Farm _____Prairie Oil & Gas Company


NORTH

250 Ft. from N. Line

_____ Ft. from S. Line

250 Ft. from E. Line

_____ Ft. from W. Line

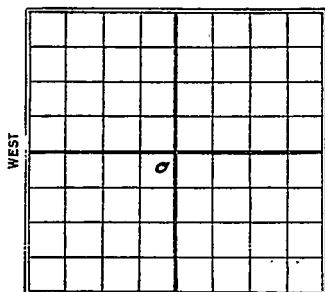

SOUTH

1927

Date

REPORT

3/9 Machine

3/16 _____

3/24 _____

3/30 Rigging up

4/7 Spudding

4/13 Drlg 700

4/20 " 850

4/27 " 1150

5/5 S.D. 1472

5/12 _____

5/25 Sand 1496-1525

1 1/2 m Gas

Map No. 9 Sec. 25 Twp. 14 R. 14

Well No. 1 Stephen son
Prairie oil & Gas Co. Company

Contractor

FIRST REPORTS


SECTION PLAT

250 Ft. from N. Line

_____ Ft. from S. Line

250 Ft. from E. Line

_____ Ft. from W. Line

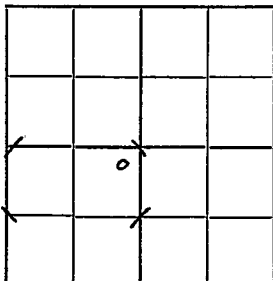

Location _____

Rig up Machine

Drilling and Remarks:

RECORD

Cased _____ in., _____ ft.

Sand _____

Gas _____

Oil _____

Total Depth _____

PRODUCTION

1st 24 hrs. Nat. _____

1st 24 hrs. after shot _____

Gas _____ Cu. Ft.

Dry Hole _____

Abandoned _____

Date

MAR 9 1927 CHAS. L. SHERWOOD

192

Scout

Woodson
 (No. 22) KANSAS
 Map No. _____ Sec. *9* Twp. *25* R. *14*
 Well No. *1* *Stephenson*
Frankie Oil & Gas Co. Company

Contractor _____

COMPLETED

SECTION PLAT

250 Ft. from N. Line

_____ Ft. from S. Line

250 Ft. from E. Line

_____ Ft. from W. Line

	o		

Location _____

Rig up _____

Drilling and Remarks:

Sub Well.

RECORD

Cased _____ in., _____ ft.

Sand *1496-1525*

Gas _____

Oil _____

Total Depth *1525*

PRODUCTION

1st 24 hrs. Nat. _____

1st 24 hrs. after shot _____

Gas *1 1/2* Cu. Ft.

Dry Hole _____

Abandoned _____

Date

MAY 25 1927

CHAS. L. SHERWOOD

192

Scout