


*Woodson*

Map No. *KANS* Sec. *9* Twp. *25* R. *14 E* ✓

Well No. *3- Stephenson* Farm  
*Fields & Cross* Company

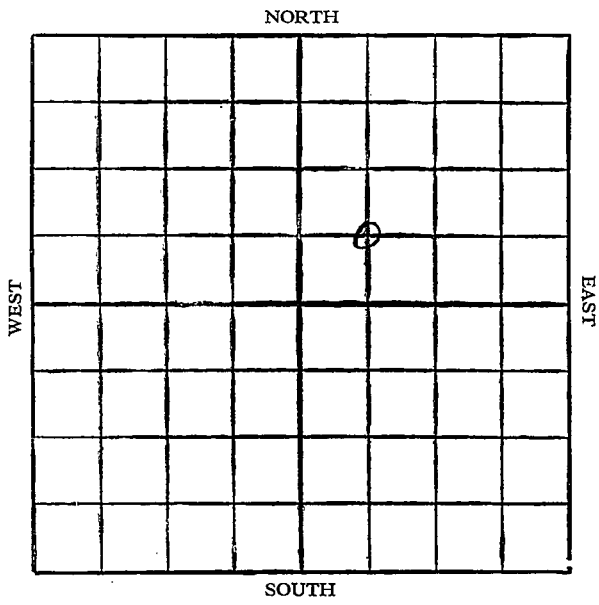

Location .....

Drilling Remarks

.....

.....

Rig Up:.....

Drilling Remarks

.....

.....

**RECORD**

Cased..... in. .... ft.

Sand .....

Gas .....

Oil .....

Total Depth.....

**PRODUCTION**

1st 24 hrs. Nat.....

1st 24 hrs. after shot.....

Gas..... cu. ft.

Dry Hole.....

Abandoned.....

Kansas

Map No. \_\_\_\_\_ Sec. 9 Twp. 25 R. 14E


Well No. 3-Stephenson Farm  
Fields & Cross Company

\_\_\_\_\_ Ft. from N. Line

660 Ft. from S. Line

\_\_\_\_\_ Ft. from E. Line

660 Ft. from W. Line

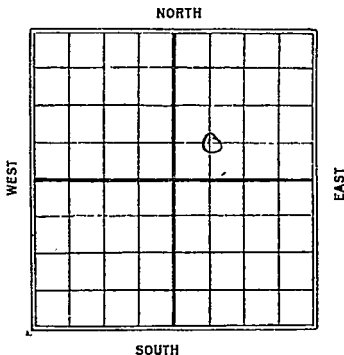

1927

Date

REPORT

1/26 Drly 550'

2/3 sand 1424-1452

2 million gas

J.D. 1452

*Woodson*

*no title*  
**KANSAS**

Map No. \_\_\_\_\_ Sec. *9* Twp. *25* R. *14* <sup>*E*</sup>

Well No. *3* *Stephenson*

*Fields & Cross* Company

Contractor

### FIRST REPORTS

### SECTION PLAT

\_\_\_\_\_ Ft. from N. Line

*660* Ft. from S. Line

\_\_\_\_\_ Ft. from E. Line

*660* Ft. from W. Line

		o	

Location \_\_\_\_\_

Rig up \_\_\_\_\_

Drilling and Remarks:

*Delay 550*

### RECORD

Cased \_\_\_\_\_ in., \_\_\_\_\_ ft.

Sand \_\_\_\_\_

Gas \_\_\_\_\_

Oil \_\_\_\_\_

Total Depth \_\_\_\_\_

### PRODUCTION

1st 24 hrs. Nat. \_\_\_\_\_

1st 24 hrs. after shot \_\_\_\_\_

Gas \_\_\_\_\_ Cu. Ft.

Dry Hole \_\_\_\_\_

Abandoned \_\_\_\_\_

Date

**JAN 26 1927**

**CHAS. L. GHERWOOD**  
Scout

*Woodson*

*no KANSAS*

Map No. \_\_\_\_\_ Sec. *9* Twp. *25* R. *14*

Well No. *3* *Stephenson*

*Fields & Cross* Company

Contractor

COMPLETED

SECTION PLAT

\_\_\_\_\_ Ft. from N. Line

*660* Ft. from S. Line

\_\_\_\_\_ Ft. from E. Line

*660* Ft. from W. Line

		o	

Location \_\_\_\_\_

Rig up \_\_\_\_\_

Drilling and Remarks:

*Sp well*

RECORD

Cased \_\_\_\_\_ in., \_\_\_\_\_ ft.

Sand *1424-1452*

Gas \_\_\_\_\_

Oil \_\_\_\_\_

Total Depth *1452*

PRODUCTION

1st 24 hrs. Nat. \_\_\_\_\_

1st 24 hrs. after shot \_\_\_\_\_

Gas *2 M* Cu. Ft.

Dry Hole \_\_\_\_\_

Abandoned \_\_\_\_\_

Date

DEC 3 1927

CHAS. L. SHERWOOD

192

Scout