


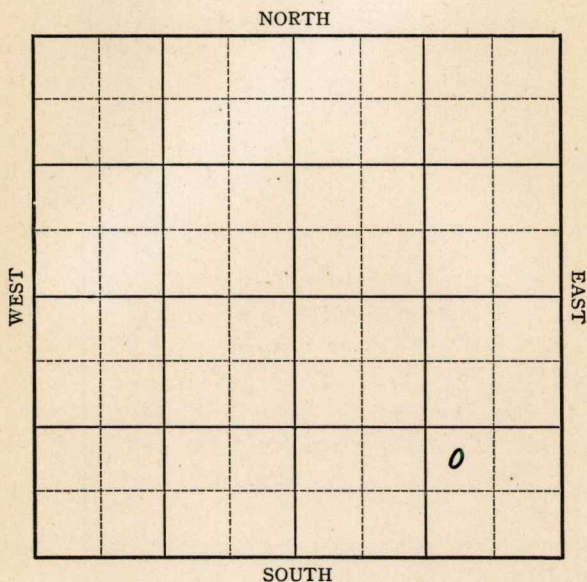

Section 16 Township 28 Range 11-E

Well No. 8. E. Wingrave

Company Selby Oil & Gas



KANSAS

Greenwood

Sec. 16 Twp. 28 R. 11-E

Well No. #8 E. Wingrave Farm

Selby Oil & Gas Company


(Severy)

_____Ft. from N. Line

990 Ft. from S. Line

990 Ft. from E. Line

Ft. from W. Line

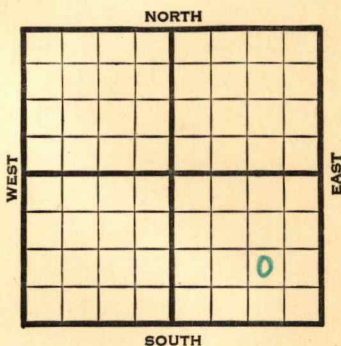[illegible]

Map No. 9 Sec. 16 Twp. 28 R. 11E

Well No. 8 E. Wingrave

Selby Oil & Gas Company

COMPLETED Contractor

NW SW SE - KGS

NW SE SE

DR

SECTION PLAT

			o

 Ft. from N. Line

990 Ft. from S. Line

990 Ft. from E. Line

 Ft. from W. Line

SEVERY POOL

Location

Rig up

Drilling and Remarks:

KC 1145
5" @ 1145
1500 acid
Pump 1000 ft

364 gr

RECORD

Cased in., ft.

Sand

Gas

Oil

Total Depth 1156

PRODUCTION

1st 24 hrs. Nat.

1st 24 hrs. after shot

Gas Cu. Ft.

Dry Hole

Abandoned

Date

JUL 16 1941 19

S. J. LEWIS Scout

Map No. 9 Sec. 16 Twp. 28 R. 11EWell No. 8 E. WingraveSelby Oil & Gas CompanyNW SE SW SE - 1165/011 Contractor

FIRST REPORT NW

~~NW SE SE~~

SECTION PLAT

			o

Ft. from N. Line

990 Ft. from S. Line990 Ft. from E. Line

Ft. from W. Line

SEVERY POOL

Location _____

Rig up _____

Drilling and Remarks:

6" - 8415" - 1145Kan. City 1145

RECORD

Cased _____ in., _____ ft.

Sand _____

Gas _____

Oil _____

Total Depth _____

PRODUCTION

1st 24 hrs. Nat. _____

1st 24 hrs. after shot _____

Gas _____ Cu. Ft.

Dry Hole _____

Abandoned _____

Date

JUL 9 194119S. J. LEWIS

Scout