

Section 16 Township 25 Range 14-E

Well No. #1 Langdon

Company Lincoln Oil

Miscellaneous

NORTH

WEST

EAST

|   |  |  |  |  |  |  |  |
|---|--|--|--|--|--|--|--|
|   |  |  |  |  |  |  |  |
|   |  |  |  |  |  |  |  |
|   |  |  |  |  |  |  |  |
|   |  |  |  |  |  |  |  |
|   |  |  |  |  |  |  |  |
| 0 |  |  |  |  |  |  |  |
|   |  |  |  |  |  |  |  |
|   |  |  |  |  |  |  |  |

SOUTH

Woodson

Sec. 16 Twp. 25 R. 14E

Well No. #1 Langdon Farm

Lincoln Oil Company

Miscellaneous


990' Ft. from N. Line

         Ft. from S. Line

         Ft. from E. Line

330' Ft. from W. Line

SW NW SW

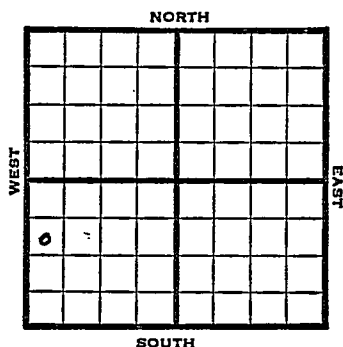

1949 REPORT

11/30

10" @ 60'  
8" @ 702'  
6" @ 1380'  
Bart 1375'  
Miss 1535'  
D&A  
TD 1575'

FIRST REPORT

ABANDONED

Map No. \_\_\_\_\_ Sec. 16 Twp. 25 R. 14E

Well No. 1 Langdon

Lincoln Oil Company

Contractor

SW NW SW

FIRST REPORT  
SECTION PLAT

990 Ft. from N. Line

Ft. from S. Line

Ft. from E. Line

330 Ft. from W. Line

|           |  |  |  |
|-----------|--|--|--|
| ABANDONED |  |  |  |
|           |  |  |  |
|           |  |  |  |
|           |  |  |  |
|           |  |  |  |

Woodson County

Location

Rig up

Drilling and Remarks:

10" @ 60

8" @ 702

6" @ 1380

Bart. 1375

Miss. 1535

D & A

RECORD

Cased \_\_\_\_\_ in., \_\_\_\_\_ ft.

Sand \_\_\_\_\_

Gas \_\_\_\_\_

Oil \_\_\_\_\_

Total Depth 1575

PRODUCTION

1st 24 hrs. Nat. \_\_\_\_\_

1st 24 hrs. after shot \_\_\_\_\_

Gas \_\_\_\_\_ Cu. Ft.

Dry Hole \_\_\_\_\_

Abandoned \_\_\_\_\_

Date

NOV 30 1940 19

S. J. LEWIS

Scout