


*Woodson* ✓

Map No. *17N* Sec. *17* Typ. *25* R. *14*

Well No. *1* *Weide* Farm

*Fields & Cross* Company

NORTH

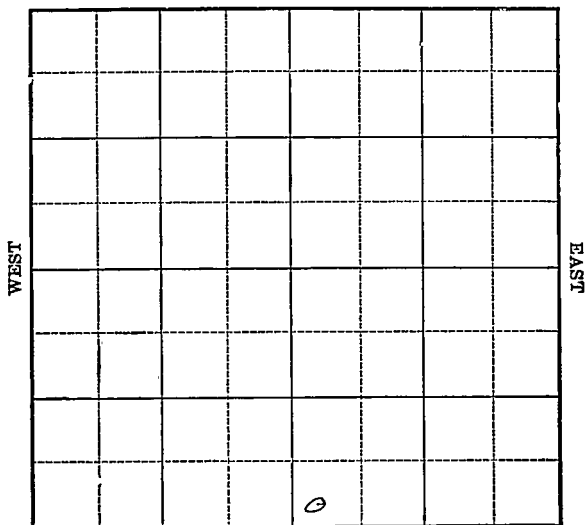

SOUTH

Location \_\_\_\_\_

Drilling Remarks \_\_\_\_\_

Rig Up \_\_\_\_\_

Drilling Remarks \_\_\_\_\_

## RECORD

Cased \_\_\_\_\_ in. \_\_\_\_\_ ft.

Sand \_\_\_\_\_

Gas \_\_\_\_\_

Oil \_\_\_\_\_

Total Depth \_\_\_\_\_

## PRODUCTION

1st 24 hrs. Nat. \_\_\_\_\_

1st 24 hrs. after shot \_\_\_\_\_

Gas \_\_\_\_\_ cu. ft.

Dry Hole \_\_\_\_\_

Abandoned \_\_\_\_\_

Woodson

Map No. 57N Sec. 17 Twp. 25 R. 14Well No. 1 Weide FarmFields & Cross Company

NORTH


\_\_\_\_\_ Ft. from N. Line

250 Ft. from S. Line

\_\_\_\_\_ Ft. from E. Line

250 Ft. from W. Line

WEST

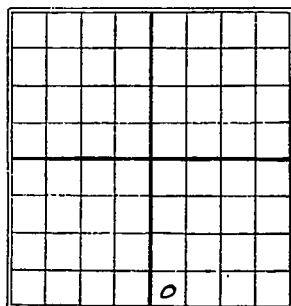

EAST

SOUTH

1926

Date

REPORT

7/28 Location

8/4

8/11

8/18

8/25

8-31

9/15

9/22

9/29

10/13

10/27

Sand 1335-47'

comp. per gas well

 $\frac{1}{2}$  million gas

Woodson  
 no map  
 KANSAS  
 Map No. \_\_\_\_\_ Sec. 17 Twp. 25 R. 14  
 Well No. 1  
 Shields & Co. Dr. Company

Contractor

## FIRST REPORTS

## SECTION PLAT

\_\_\_\_\_ Ft. from N. Line

250 \_\_\_\_\_ Ft. from S. Line

\_\_\_\_\_ Ft. from E. Line

250 \_\_\_\_\_ Ft. from W. Line

|  |  |   |  |
|--|--|---|--|
|  |  |   |  |
|  |  |   |  |
|  |  |   |  |
|  |  | 0 |  |

Location \_\_\_\_\_ ✓

Rig up \_\_\_\_\_

Drilling and Remarks:

## RECORD

Cased \_\_\_\_\_ in., \_\_\_\_\_ ft.

Sand \_\_\_\_\_

Gas \_\_\_\_\_

Oil \_\_\_\_\_

Total Depth \_\_\_\_\_

## PRODUCTION

1st 24 hrs. Nat. \_\_\_\_\_

1st 24 hrs. after shot \_\_\_\_\_

Gas \_\_\_\_\_ Cu. Ft.

Dry Hole \_\_\_\_\_

Abandoned \_\_\_\_\_

Date

JUL 28 1926

CHAS. L. SHERWOOD

192

Scout

*Woods*  
 Map No. 1 **KANSAS** Sec. 17 Twp. 25 R. 14  
 Well No. 1 *Wells*  
*Fuels & Co.* Company

Contractor

## COMPLETED

## SECTION PLAT

Ft. from N. Line

750

Ft. from S. Line

Ft. from E. Line

750

Ft. from W. Line

|  |  |   |  |
|--|--|---|--|
|  |  |   |  |
|  |  |   |  |
|  |  |   |  |
|  |  | 0 |  |

Location

Rig up

Drilling and Remarks:

*Comp for 1/2 in. 1480'*

## RECORD

Cased \_\_\_\_\_ in., \_\_\_\_\_ ft.

Sand 1335-47'

Gas \_\_\_\_\_

Oil \_\_\_\_\_

Total Depth 1480'

## PRODUCTION

1st 24 hrs. Nat. \_\_\_\_\_

1st 24 hrs. after shot \_\_\_\_\_

Gas 1 1/2 M Cu. Ft.

Dry Hole \_\_\_\_\_

Abandoned \_\_\_\_\_

Date

OCT 27 1926

CHAS. L. SHERWOOD