
FORM 51 25M 8-50 WESTERN

Section 12 Township Barton 16 Range KANSAS 12W

Well No. #10 #9 Weber "A"

Company H. E. Alexander

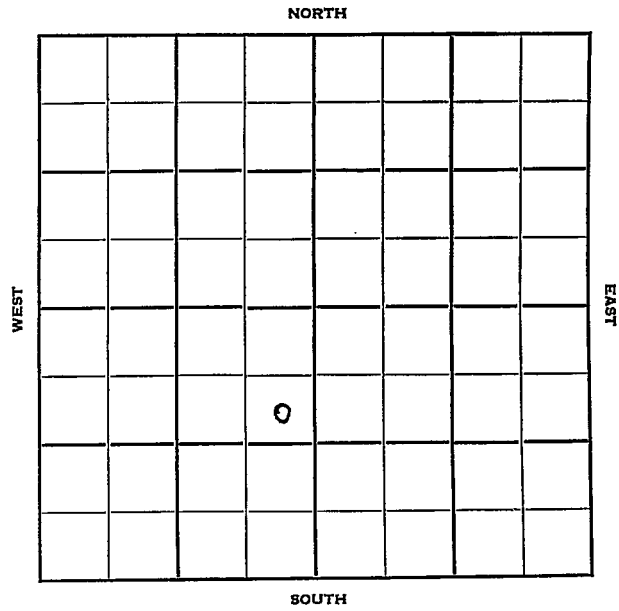

FORM 252-B

Barton

KANSAS

Sec. 12 Twp. 16 R. 12W

Well No. ~~#9~~ #10 Weber "A" Farm

H.E. Alexander

Company

Kraft-Prusa Pool

Contractor


990 Ft. from N. Line

Ft. from S. Line

330 Ft. from E. Line

Ft. from W. Line

SE NE SW

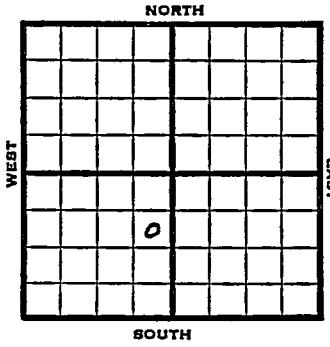

1953	Elev. 1886' REPORT
5/27 6/10	Location 8" @ 442' Anhy 730' Drlg 1954'
6/24	N.R.
7/22	NR
8/5	pud 6-4-53 Gas Well TD 3370 8" @ 442' Anhy 730, Lans 3040, Cong 3297, Arb. 3326 DST 3329-38, opn 1 hr., rec. 30' ocm, 60' wtr., mud & oil, 955# TD 3370 5" @ 3369, CO to 3346, 18/3331-34, 250A, 24 bo 55 bw 8 hrs., SP 2973 20/2951-55, 500A, 9 mcfg, 2000A 1¼ mcfg, Dodge 2949 Comp. 1½ mcfgpd COMPLETED

FORM 275 FOR SALE BY KANSAS BLUE PRINT CO.

County Barton State Kansas

Sec. 12 (Blk. Twp.) 16 (Sur. Rge.) 12W Map No.

Operator H. E. Alexander

Well No. 9 Farm Weber "A"

Elev. Location SE NE SW



990 Ft. From N Line SW

330 Ft. From E Line Quarter

1st. Report MAY 27 1953

Completion

Remarks

Spudding Date

Drlg. Data Kraft-Prusa Pool

Location

J. G. McGEHEE

FORM 26 200 BKS. 4-52 PETROL

Kansas

Map No. _____ Sec. 12 Twp. 16 R. 12W

Well No. 10 Weber "A"

H. E. Alexander Company

CORRECTION Contractor

SE NE SW


990 Ft. from N. Line

_____ Ft. from S. Line

330 Ft. from E. Line

_____ Ft. from W. Line

SECTION PLAT

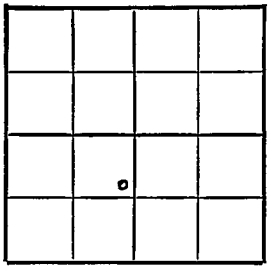

Barton County

Location _____

Rig up _____

Drilling and Remarks:

Reported
#9 Weber "A"

RECORD

Cased _____ in., _____ ft.

Sand _____

Gas _____

Oil _____

Total Depth _____

PRODUCTION

1st 24 hrs. Nat. _____

1st 24 hrs. after shot _____

Gas _____ Cu. Ft.

Dry Hole _____

Abandoned _____

Date

JUN 24 1953 19

J. G. McGEHEE Scout

FORM 275 FOR SALE BY KANSAS BLUE PRINT CO.


County Barton State Kansas

Sec. 12 (Blk. Twp.) 16 (Sur. Rge.) 12W Map No.

Operator H. E. Alexander

Well No. 10 Farm Weber "A"

Elev. 1886 Location SE NE SW

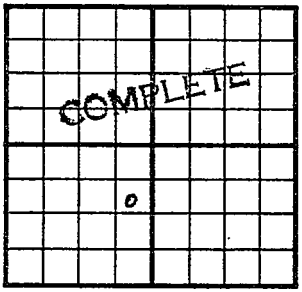

990 Ft. From N Line SW

330 Ft. From E Line Quarter

1st. Report

Completion AUG 5 1953

Remarks Kraft-Prusa Pool

Spudding Date 6-4-53

Drlg. Data Gas well TD 3370

8" @ 442 Anhy 730 Lans. 3040

Cong. 3297 Arb. 3326 DST 3329-38

open 1 hr. Rec. 30' ocm 60' wtr.

mud & oil 955# TD 3370 5" @ 3369

CO to 3346 18/ 3331-34 250 A

24 bo 55 bw 8 hr. SP 2973 20/ 2951-55

500 A 9 mcfg 2000 A 1½ mcfg

Dodge 2949 Comp. 1½ mcfgpd

J. G. McGEHEE