


Section 12 Township 16 Range 12W

Well No. #2 Woydziak

Company Blak-Marshall

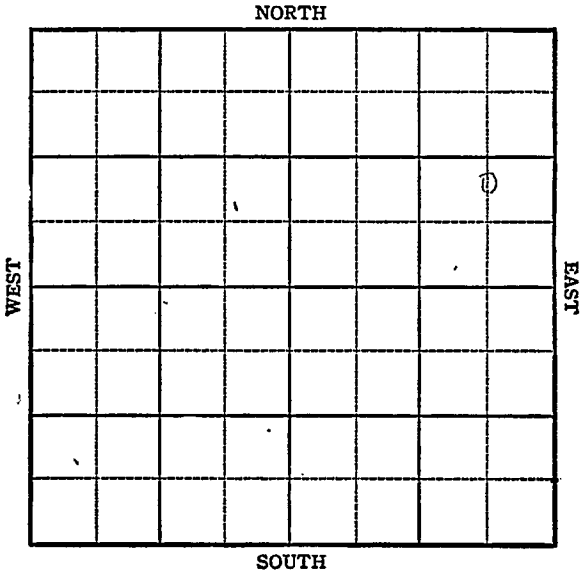

**KANSAS**

Sec. 12 Twp. 16 R. 12W

Well No. #2 Woydziak Farm

Black-Marshall Company


Kraft Prussa

\_\_\_\_\_ Ft. from N. Line

990 Ft. from S. Line

660 Ft. from E. Line

\_\_\_\_\_ Ft. from W. Line

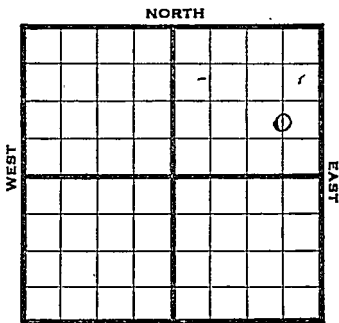

Barton C N L SE NE

1944 Elev. 1884 R E P O R T

- 11/29 Loc.
- 12/6 ~~Derrick~~
- 12/14 Derrick
- 12/21 RUR
- 12/29 Suffact hole
- 1945
- 1/3 10" @ 245 Drlg 2159
- 1/10 Drlg 3142
- 1/17 Lans 3035
- Cong 3312
- Arb 3328 -35 TD
- 5" @ 3330 Rust
- 1/26 " " " " "
- 1/31 Lans 3030
- Arb. 3323 corrected
- 5" @ 3325
- TD 3330
- Pump 30 oil in 3 hrs.
- 2/7 " " " " " "
- 2/14 " " " " " "
- 2/21 Arb. 3323
- 5" @ 3325
- TD 3335'
- Depth Pot. 6084 Max. 3000
- Grav. 42.0

**COMPLETED**

Pool Name Kraft Prns a

Map No. 55 Sec. 12 Twp. 16 R. 12W

Well No. 2 Woydziak

Black-Marshall Company

FIRST REPORT Contractor

C N L S E N E

SECTION PLAT

           Ft. from N. Line

990 Ft. from S. Line

660 Ft. from E. Line

           Ft. from W. Line

			o

Barton

Location X

Rig up           

Drilling and Remarks:

RECORD

Cased            in,            ft.

Sand           

Gas           

Oil           

Total Depth           

PRODUCTION

1st 24 hrs. Nat.           

1st 24 hrs. after shot           

Gas            Cu. Ft.

Dry Hole           

Abandoned           

Date

NOV 29 1944

19

S. J. LEWIS Scout.

