

PT 5-30-1E

STATE CORPORATION COMMISSION OF KANSAS OIL & GAS CONSERVATION DIVISION

WELL COMPLETION OR RECOMPLETION FORM ACO-1 WELL HISTORY

DESCRIPTION OF WELL AND LEASE

Operator: license # 5002 name George R. Jones address 125 N. Market Suite 1210 City/State/Zip Wichita, KS 67202

Operator Contact Person George R. Jones Phone 316/262-5503

Contractor: license # 5302 name Red Tiger Drilling Company

Wellsite Geologist Robert W. Hammond Phone 316/262-5503

PURCHASER

Designate Type of Completion

[X] New Well [] Re-Entry [] Workover

- [] Oil [] SWD [] Temp Abd [] Gas [] Inj [] Delayed Comp. [X] Dry [] Other (Core, Water Supply etc.)

If Old Well Info as follows:

Operator Well Name Comp. Date Old Total Depth

WELL HISTORY

Drilling Method: [X] Mud Rotary [] Air Rotary [] Cable Spud Date 8/1/84 Date Reached TD 8/15/84 Completion Date 8/16/84

Total Depth 4120' PBDT

Amount of Surface Pipe Set and Cemented at 7 jts @ 302' feet

Multiple Stage Cementing Collar Used? [] Yes [X] No

If Yes, Show Depth Set feet

If alternate 2 completion, cement circulated from feet depth to w/ SX cmt

Wireline Log Rec'd

API NO. 15-191-21,722

County Sumner

SW SW NE Sec 5 Twp 32 Rge 1 West

2970 Ft North from Southeast Corner of Section 2310 Ft West from Southeast Corner of Section (Note: locate well in section plat below)


Lease Name Horsch Well# 1

Field Name

Producing Formation

Elevation: Ground 1280 ft. KB 1287'

Section Plat

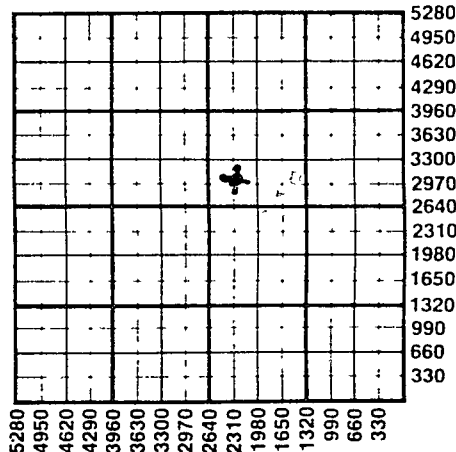

WATER SUPPLY INFORMATION

Source of Water:

Division of Water Resources Permit #

[] Groundwater Ft North From Southeast Corner and (Well) Ft. West From Southeast Corner of Sec Twp Rge [] East [] West

[] Surface Water Ft North From Southeast Corner and (Stream, Pond etc.) Ft West From Southeast Corner Sec Twp Rge [] East [] West

[X] Other (explain) City of Wellington (purchased from city, R.W.D.#)

Disposition of Produced Water: [] Disposal [] Repressuring

Docket #

INSTRUCTIONS: This form shall be completed in duplicate and filed with the Kansas Corporation Commission, 200 Colorado Derby Building, Wichita, Kansas 67202, within 90 days after completion or recompletion of any well. Rules 82-3-130 and 82-3-107 apply.

Information on side two of this form will be held confidential for a period of 12 months if requested in writing and submitted with the form. See rule 82-3-107 confidentiality in excess of 12 months.

Copy of all wireline logs and drillers time log shall be attached with this form. Submit CP-4 form with all plugged wells. Submit CP-111 form with early abandoned wells.