34 - 16 - 12W

WELL LOG BUREAU—KANSAS GEOLOGICAL SOCIETY
503 East Murdock, Wichita, Kansas

Company- SHIELDS OIL PRODUCERS
Farm- Feltes No. 2

SEC. 34 T. 16 R. 12W
SW NW NE

County Barton
KANSAS

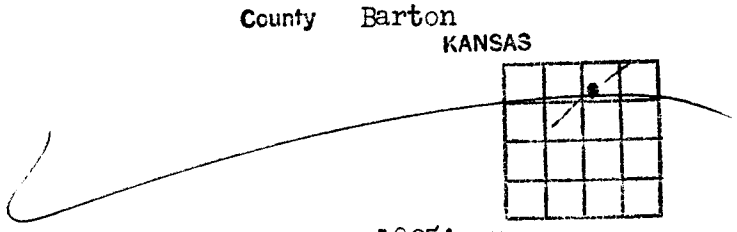

Total Depth. 3530'
Comm. 1-10-56 Comp. 1-22-56
Shot or Treated.
Contractor. Shields Drlg. Co.
Issued. 3-31-56

Elevation. 1895' RB

Production. SWDW

CASING:
8 5/8" 200' cem w/100 sx
4 1/2" 3410' cem w/100 sx

Figures Indicate Bottom of Formations.

surface clay	50	
lime strks & shale	200	
shale	360	
sand	510	
red bed	780	
anhydrite	810	
red bed & shale	1050	
shale-shells & salt	1295	
shale & shells	1420	
lime & shale	1515	
shale & lime	1615	
lime & shale	1735	
shale & lime	1865	
lime & shale	1970	
lime	2030	
lime & shale	2160	
shale	2647	
shale & lime	2728	
lime & shale	2856	
lime	3013	
shale & lime	3100	
lime	3525	RTD
Total Depth		

Tops:

Heebner	2970
Toronto	2987
Brown Lime	3060
Lansing-Kansas City	3077
Ch. Conglomerate	3337
Arbuckle	3367
Sand	3524