


Map No. **KANSAS** Sec. 29 Twp. 28 R. 12^E

Well No. 1- Douglas Farm
Denton et al Company

NORTH

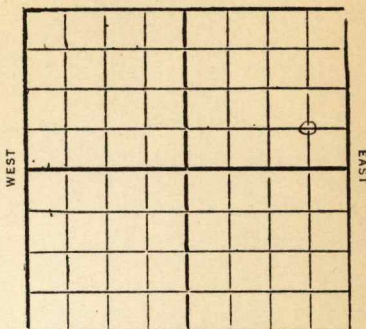

SOUTH

 Ft. from N. Line

660 Ft. from S. Line

660 Ft. from E. Line

 Ft. from W. Line

1932

Date

REPORT

9/21 Top line 1744
show gas
T.D. 1827
Dry & Abandon

ELK

E

9 **KANSAS** Sec. 29 Twp. 28 R. 12

Well No. 1 *Douglas*
Denton et al Company

Contractor

FIRST REPORTS**SECTION PLAT**

Ft. from N. Line

660 Ft. from S. Line

660 Ft. from E. Line

Ft. from W. Line

COMPLETED

0

Location

Rig up

Drilling and Remarks:

Top Line 1744
Show gas

RECORD

Cased, in., ft.

Sand

Gas

Oil

Total Depth 1827

PRODUCTION

1st 24 hrs. Nat.

1st 24 hrs. after shot

Gas Cu. Ft.

Dry Hole ✓

Abandoned ✓

Date

SEP 2 1 1932

CHAS. L. SHERWOOD

192

Scout