


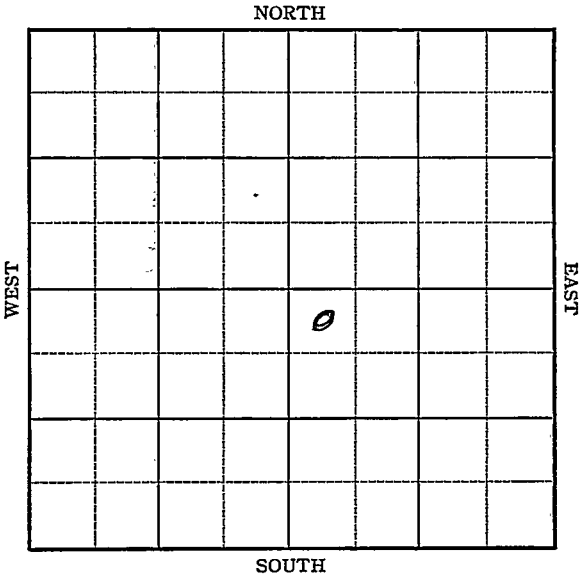

Section 18 Township 25 Range 14-E

Well No. #1 Weide

Company Chas Reeser et al



Sec. 18 Twp. 25 R. 14-E


Well No. #1 Weide Farm
Chas. Reeser et al Company

330 Ft. from N. Line

_____ Ft. from S. Line

_____ Ft. from E. Line

330 Ft. from W. Line

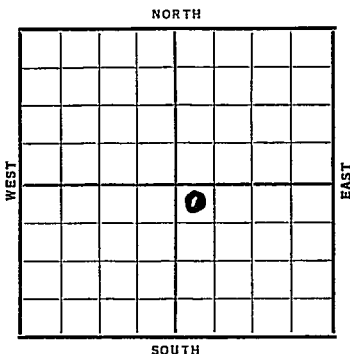

Date	REPORT
1937	
10/20	Mach.
10/29	"
11/5	Drl g. 750'.
11/12	6" @ 1139' SD 1150'.
11/19	" " " "
11/26	SD 1340'.
12/1	5" @ 1536'.
	Miss. 1531'.
	T.D. 1556'.
	H.F.W.
	COMPLETED ABANDONED

Woodson

KANSAS

Map No. 17 Sec. 18 Twp. 25 R. 14EWell No. 1 WeideChas Reeser etal Company

Contractor

FIRST REPORT

NW SE

330 Ft. from N. Line

_____ Ft. from S. Line

_____ Ft. from E. Line

330 Ft. from W. Line

SECTION PLAT

		0	

Location _____

Rig up _____

Drilling and Remarks:

Mach _____

RECORD

Cased _____ in., _____ ft.

Sand _____

Gas _____

Oil _____

Total Depth _____

PRODUCTION

1st 24 hrs. Nat. _____

1st 24 hrs. after shot _____

Gas _____ Cu. Ft.

Dry Hole _____

Abandoned _____

Date

OCT 20 1937 19 H. D. Hatfield Scout

Woods on **KANSAS**Map No. 17 Sec. 18 Twp. 25 R. 14EWell No. 1 WeideChas Reeser etal Company

Contractor

ABANDONED

NW SE

330 Ft. from N. Line

_____ Ft. from S. Line

_____ Ft. from E. Line

330 Ft. from W. Line**SECTION PLAT**

		0	

Location _____

Rig up _____

Drilling and Remarks:

HFW

DVA

RECORDCased 5 in. 1536 ft.Sand MISS 1531

Gas _____

Oil _____

Total Depth 1556**PRODUCTION**

1st 24 hrs. Nat. _____

1st 24 hrs. after shot _____

Gas _____ Cu. Ft.

Dry Hole _____

Abandoned _____

Date

DEC 1 - 1937

19

H. D. Hatfield

Scout