


Map No. **KANSAS** Sec. 18 Twp. 25 R. 14E

Well No. 1 - Witty Farm _____

Kite et al Company _____

Woodson

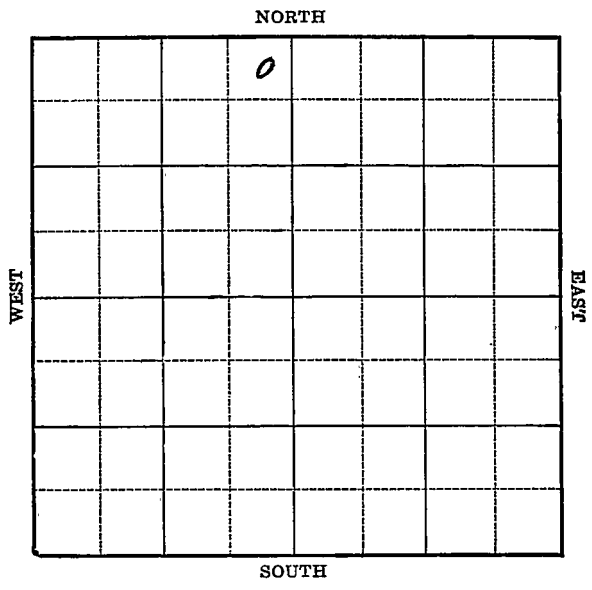

Location _____

Drilling Remarks _____

Rig Up _____

Drilling Remarks _____

RECORD

Cased _____ in. _____ ft.

Sand _____

Gas _____

Oil _____

Total Depth _____

PRODUCTION

1st 24 hrs. Nat. _____

1st 24 hrs. after shot _____

Gas _____ cu. ft. _____

Dry Hole _____

Abandoned _____

Map No. 17 Sec. 18 Twp. 25 R. 14E

Well No. 1 - Witty
Kite et al Company

Contractor

FIRST REPORTS

SECTION PLAT

330 Ft. from N. Line
 _____ Ft. from S. Line
330 Ft. from E. Line
 _____ Ft. from W. Line

	0		

Location _____
 Rig up _____
 Drilling and Remarks:

Rel 275

RECORD

Cased _____ in., _____ ft.
 Sand _____
 Gas _____
 Oil _____
 Total Depth _____

PRODUCTION

1st 24 hrs. Nat. _____
 1st 24 hrs. after shot _____
 Gas _____ Cu. Ft.
 Dry Hole _____
 Abandoned _____

Date

3-20-35

192

ORVAL MANNSCHECK

Scout

Map No. 17 Sec. 18 Twp. 25 R. 14 E

Well No. 1- Witty
Kite et al Company

Contractor

SECTION PLAT

330 Ft. from N. Line
 _____ Ft. from S. Line
330 Ft. from E. Line
 _____ Ft. from W. Line

		0	

ABANDONED

Location _____

Rig up _____

Drilling and Remarks:

10 + 1/2

RECORD

Cased _____ in., _____ ft.

Sand lime 1576

Gas _____

Oil _____

Total Depth 1603

PRODUCTION

1st 24 hrs. Nat. _____

1st 24 hrs. after shot _____

Gas _____ Cu. Ft.

Dry Hole _____

Abandoned _____

Date

4-17-35

192