

KANSAS


Greenwood

Form 51—5M—7-40—Palace

Section 17 Township 28 Range 11-E

Well No. #2 Jabes

Company Harper, Vandeventer et al

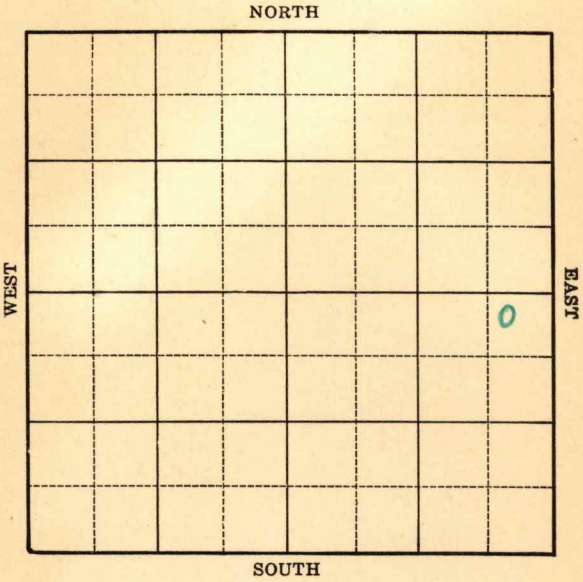

Map No. 9 Sec. 17 Twp. 28 R. 11E

Well No. 2 Jabes

Harper, Vandeventer et al Company

FIRST REPORT

Contractor

SECTION PLAT

NE SE

| | | | |
|--|--|--|---|
| | | | |
| | | | |
| | | | o |
| | | | |

190 Ft. from N. Line

_____ Ft. from S. Line

_____ Ft. from E. Line

490 Ft. from W. Line

SEVERY POOL

Location X

Rig up _____

Drilling and Remarks:

RECORD

Cased _____ in., _____ ft.

Sand _____

Gas _____

Oil _____

Total Depth _____

PRODUCTION

1st 24 hrs. Nat. _____

1st 24 hrs. after shot _____

Gas _____ Cu. Ft.

Dry Hole _____

Abandoned _____

Date

FEB 12 1941 19

S. J. LEWIS Scout

Map No. 9 Sec. 17 Twp. 28 R. 11E

Well No. 2 Jabes

Harper Vandeventer et al Company

Contractor

COMPLETED

SECTION PLAT

NE SE

190 Ft. from N. Line

_____ Ft. from S. Line

_____ Ft. from E. Line

490 Ft. from W. Line

| | | | |
|--|--|--|---|
| | | | |
| | | | |
| | | | o |
| | | | |

SEVERY POOL

Location _____

Rig up _____

Drilling and Remarks:

KC 1220

6" C 1213

1000 acid

Pump 50 P 8

330 Gr

RECORD

Cased _____ in., _____ ft.

Sand _____

Gas _____

Oil _____

Total Depth 1223

PRODUCTION

1st 24 hrs. Nat. _____

1st 24 hrs. after shot _____

Gas _____ Cu. Ft.

Dry Hole _____

Abandoned _____

Date

MAR 5 1941 19

S. J. LEWIS Scout