

KANSAS

Form 51—5M—7-40—Palace

Greenwood

Section 17 Township 28 Range 11-E

Well No. #3 Jabes

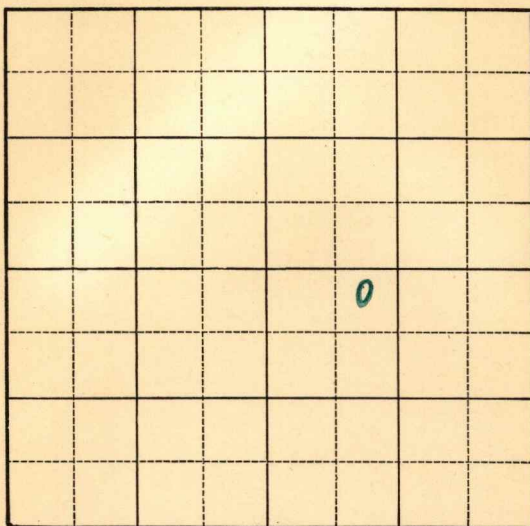
Company Harper et al

Severy Pool

NORTH

WEST

EAST



SOUTH

KANSAS

Greenwood

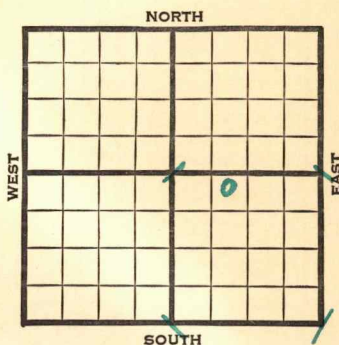
Sec. 17 Twp. 28 R. 11-EWell No. #3 Jabes FarmHarper et al Company

(Severy)

150 Ft. from N. Line

Ft. from S. Line

Ft. from E. Line

960 Ft. from W. Line

1941

REPORT

3/5

Machine.

3/13

10" - 529' Drlg. 725'

3/20

Lans. 1092' 6" - 1216' WOC.

3/26

Lans. 1092'

6" - 1216'

T.D. 1223'

1500 acid.

Potential 50 bbls., pump.

38. Gravity

COMPLETED

Map No. 9 Sec. 17 Twp. 28 R. 11EWell No. 3 J abes

Harper et al

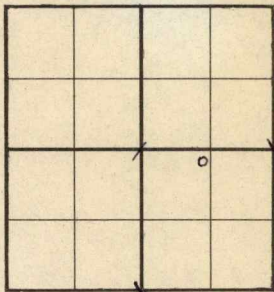
Company

FIRST REPORT

Contractor

SECTION PLAT

NE NW SE

150 Ft. from N. Line Ft. from S. Line Ft. from E. Line960 Ft. from W. Line

SEVERY POOL

Location Rig up

Drilling and Remarks:

Machine

RECORD

Cased in., ft.Sand Gas Oil Total Depth

PRODUCTION

1st 24 hrs. Nat. 1st 24 hrs. after shot Gas Cu. Ft.Dry Hole Abandoned

Date

MAR 5 1941 19S. J. LEWIS Scout

Map No. 9 Sec. 17 Twp. 28 R. 11EWell No. 3 JabesHarper et al

Company

Contractor

COMPLETED

NE NW SE

150 Ft. from N. Line Ft. from S. Line Ft. from E. Line960 Ft. from W. Line

SEVERY POOL

SECTION PLAT

		0	

Location Rig up

Drilling and Remarks:

*Same 1092**6" C 1216**1500 acid**Pump 50 Ps**38° Gr.***RECORD**Cased in., ft.Sand Gas Oil Total Depth: 1223**PRODUCTION**1st 24 hrs. Nat. 1st 24 hrs. after shot Gas Cu. Ft.Dry Hole Abandoned

Date

MAR 26 1941 19

S. J. LEWIS Scout