

KANSAS

Form 51-5M-7-40-Palace

Greenwood

Section 17 Township 28 Range 11-E

Well No. # 1 Roberts

Company G. E. Glaman


Severy Pool

NORTH

WEST


EAST

SOUTH

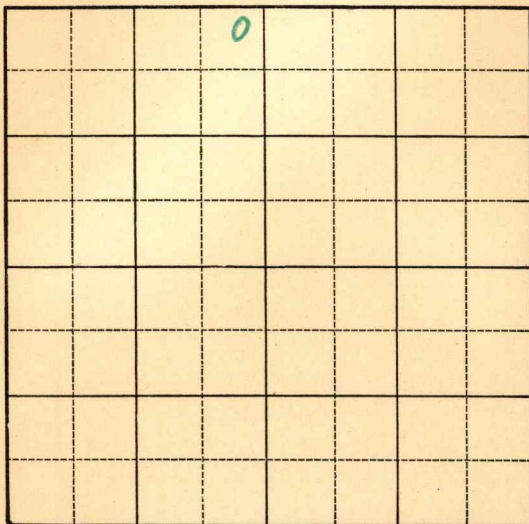

Sec. 17 Twp. 28 R. 11-EWell No. #1 Roberts FarmG. E. Glaman Company

(Severy)

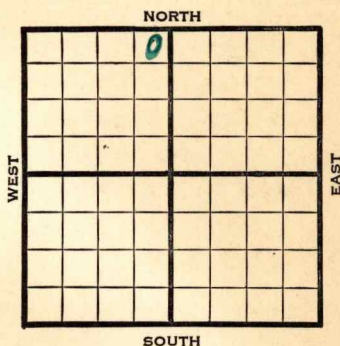100 Ft. from N. Line Ft. from S. Line100 Ft. from E. Line Ft. from W. Line

1940

REPORT

10/2

Drlg. 500'

10/10

8" - 546' Top. 756'

Drlg. 1090'

10/16

K.C. 1098'

T.D. 1250'

No shows.

ABANDONED

Map No. 9 Sec. 17 Twp. 28 R. 11EWell No. 1 RobertsG. E. Glaman

Company

Contractor

FIRST REPORT

NE NW

100 Ft. from N. Line Ft. from S. Line100 Ft. from E. Line Ft. from W. Line

SEVERY POOL

SECTION PLAT

Location Rig up

Drilling and Remarks:

Drlg. 500'**RECORD**Cased in., ft.Sand Gas Oil Total Depth **PRODUCTION**1st 24 hrs. Nat. 1st 24 hrs. after shot Gas Cu. Ft.Dry Hole Abandoned

Date

OCT 2 194019S. J. LEWIS Scout

Map No. 9 Sec. 17 Twp. 28 R. 11EWell No. 1 RobertsG. E. Glaman

Company

Contractor

ABANDONED**NE NW**100 Ft. from N. Line Ft. from S. Line100 Ft. from E. Line Ft. from W. Line**SEVERY POOL****SECTION PLAT**

Location Rig up

Drilling and Remarks:

*KC 1098**No shows***RECORD**Cased in., ft.Sand Gas Oil Total Depth 1250**PRODUCTION**1st 24 hrs. Nat. 1st 24 hrs. after shot Gas Cu. Ft.Dry Hole Abandoned

Date

OCT 16 194019S. J. LEWIS Scout