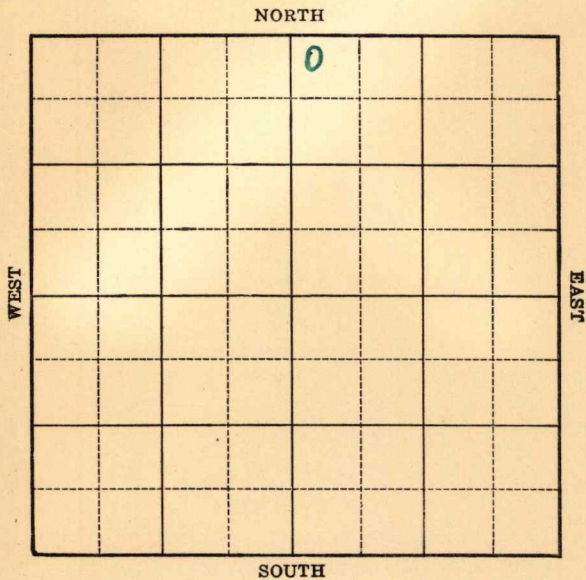


Section 17 Township 28 Range 11EWell No. #1 SandersCompany Creel et al

1940	REPORT
7/10	Spud.
7/18	10" - 20' Drlg. 475'
7/25	8" - 520' Drlg. 540'
8/2	Drlg. 810'
8/8	6" - 1229' S.O. 1232-35' T.D.
	WOC.
8/14	"
8/21	K.C. 1213'
	6" - 1229'
	T.D. 1235'
	1500 acid.
	Pump 30 bbls.
	COMPLETED

Map No. 7 Sec. 17 Twp. 28 R. 11EWell No. 1 ?Creel et al

Company

Contractor

FIRST REPORT

NW NE

190 Ft. from N. Line Ft. from S. Line Ft. from E. Line280 Ft. from W. Line

SEVERY POOL

SECTION PLAT

		0	

Location Rig up Drilling and Remarks:
Spud

RECORD

Cased in., ft.Sand Gas Oil Total Depth

PRODUCTION

1st 24 hrs. Nat. 1st 24 hrs. after shot Gas Cu. Ft.Dry Hole Abandoned

Date

JUL 10 1940 19S. J. LEWIS Scout

Map No. 9 Sec. 17 Twp. 28 R. 11E

Well No. 1 Saunders

Creel etal

Company

Contractor

COMPLETED

SECTION PLAT

		0	

NW NE

190 Ft. from N. Line

Ft. from S. Line

Ft. from E. Line

280 Ft. from W. Line

SEVERY POOL

Location _____

Rig up _____

Drilling and Remarks:

KC 1213

6 "C 1228

1500 acd

Pump 30 8 1/4

RECORD

Cased _____ in., _____ ft.

Sand _____

Gas _____

Oil _____

Total Depth 1235

PRODUCTION

1st 24 hrs. Nat. _____

1st 24 hrs. after shot _____

Gas _____ Cu. Ft.

Dry Hole _____

Abandoned _____

Date

AUG 21 1949

S. J. LEWIS Scout