

KANSAS

Form 51—5M—7-40—Palace

Greenwood




Section 17 Township 28 Range 11-E

Well No. #1 Shell Est.

Company Lemon et al

NORTH Severy Pool

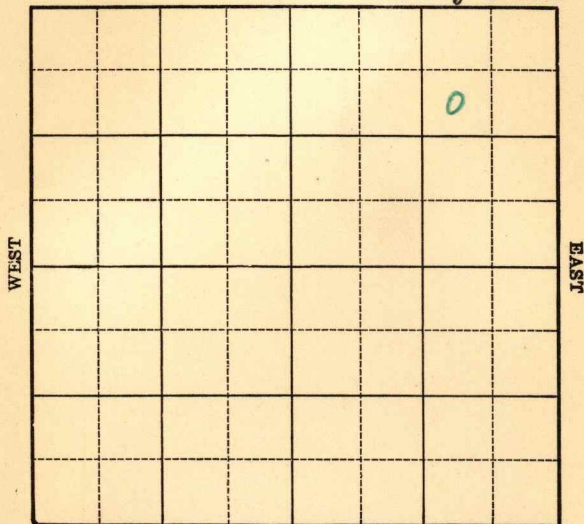

SOUTH

Sec. 17 Twp. 28 R. 11-EWell No. #1 Shell Est. FarmLemon et al

Company

(Severy)

990


Ft. from N. Line

Ft. from S. Line

990

Ft. from E. Line

Ft. from W. Line

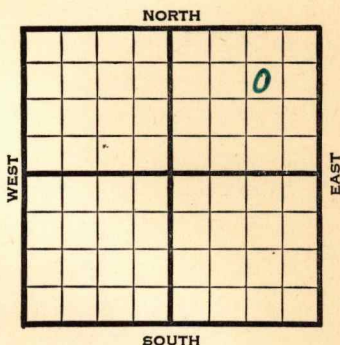

1940

REPORT

10/2

Drlg. 200'

10/10

8" - 540' Drlg. 650'

10/17

K.C. 1088' 5" - 1216' WOC.

10/24

" " " " "

10/30

K.C. 1088'

5" - 1216'

T.D. 1230'

1000 acid.

Potential 30 bbls., pump.

COMPLETED

Map No. 9 Sec. 17 Twp. 28 R. 11EWell No. 1 Shell EstLemon etal Company

Contractor

FIRST REPORT990 SW NE NE
Ft. from N. Line

Ft. from S. Line

990 Ft. from E. Line

Ft. from W. Line

SEVERY POOL**SECTION PLAT**

			o

Location _____

Rig up _____

Drilling and Remarks:

Drlg. 200'

RECORD

Cased _____ in., _____ ft.

Sand _____

Gas _____

Oil _____

Total Depth _____

PRODUCTION

1st 24 hrs. Nat. _____

1st 24 hrs. after shot _____

Gas _____ Cu. Ft.

Dry Hole _____

Abandoned _____

Date

OCT 2 1940₁₉S. J. LEWIS Scout

Map No. 9 Sec. 17 Twp. 28 R. 11EWell No. 1 Shell Est.Lemon et al

Company

Contractor

COMPLETED

SW NE NE

990 Ft. from N. Line Ft. from S. Line990 Ft. from E. Line Ft. from W. Line

Severy Pool

SECTION PLAT

Location Rig up

Drilling and Remarks:

*KC 1088**5" @ 1216**1000 acid**Pump 30 RY*

RECORD

Cased in., ft.Sand Gas Oil Total Depth 1280

PRODUCTION

1st 24 hrs. Nat. 1st 24 hrs. after shot Gas Cu. Ft.Dry Hole Abandoned

Date

OCT 30 1940 19S. J. LEWIS

Scout