

KANSAS


FORM 51 5M 6-46 PETROL

Barton County

Section 13 Township 16 Range 12W

Well No. 8 Dolecheck

Company R. E. Day

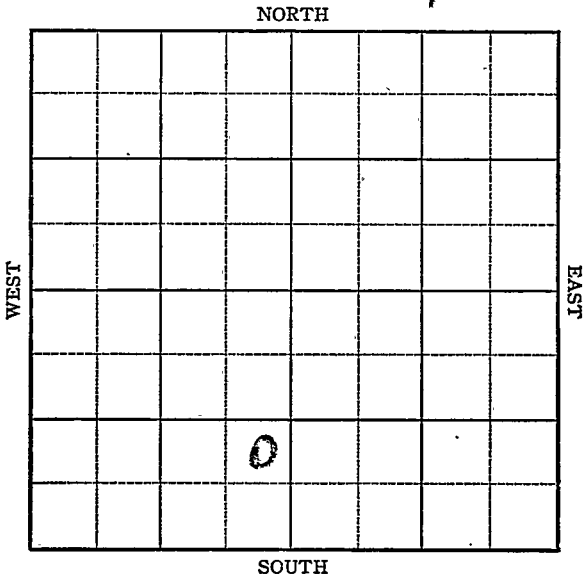

KANSAS

Barton County ✓

Sec. 13 Twp. 16 R. 12W

Well No. #8 Dolecheck Farm

R. E. Day Company

Kraft-Prusa


 Ft. from N. Line

990 Ft. from S. Line

330 Ft. from E. Line

 Ft. from W. Line

NE SE SW

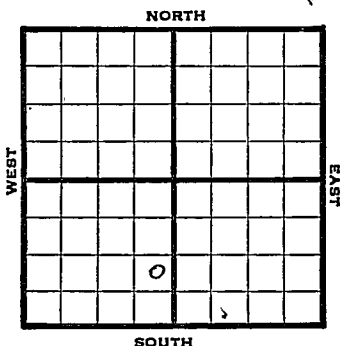

1946 Elev 1890' REPORT

8/7 Rig
8/13 "
8/20 "
8/27 TD 300 skid rig
9/5 " "
9/11 TD 300'

ABANDONED

KANSAS Pool Name Kraft-Prusa
 Kansas
 Map No. 5 Sec. 13 Twp. 16 R. 12W
 Well No. 8 Dolecheck

R. E. Day Company

FIRST REPORT

Contractor

NE SE SW

SECTION PLAT

_____ Ft. from N. Line

990 Ft. from S. Line330 Ft. from E. Line

_____ Ft. from W. Line

Barton County

Location _____

Rig up _____

Drilling and Remarks:

Rig

RECORD

Cased _____ in., _____ ft.

Sand _____

Gas _____

Oil _____

Total Depth _____

PRODUCTION

1st 24 hrs. Nat. _____

1st 24 hrs. after shot _____

Gas _____ Cu. Ft.

Dry Hole _____

Abandoned _____

Date

AUG 7 1946 19S. J. LEWIS Scout

