


Greenwood

Section 17 Township 28 Range 11-E

Well No. 1 Shoemaker

Company C. C. Whittaker et al

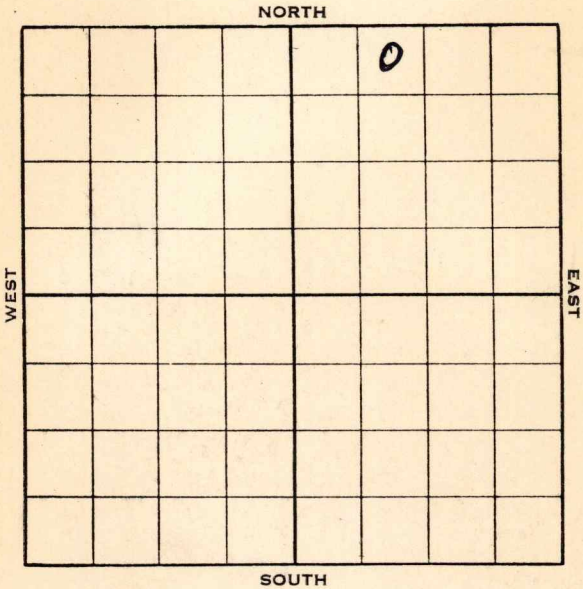


KANSAS

Greenwood

Sec. 17 Twp. 28 R. 11-EWell No. #1 Shoemaker Farm
C. C. Whittaker et al Company330 Ft. from N. Line

Ft. from S. Line

Ft. from E. Line

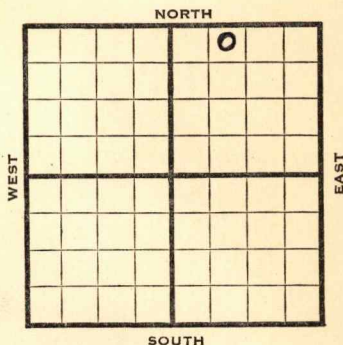990 Ft. from W. Line

1938

REPORT

6/1	10" at 385'.
	Drlg. 450'.
6/10	SD 500'.
6/17	" "
6/24	8" - 525'. Drlg. 700'.
7/1	Drlg. 915'
7/8	Drlg. 1200'.
7/15	T. D. 1203'. Rng. 6".
7/22	4" - 1202'. T.D. 1230'.
	150' fluid.
7/29	Testing.
8/3	4" at 1202'.
	K. C. 1203'.
	T. D. 1230'.
	10 oil & 20 water.

COMPLETED ~~ABANDONED~~ COMPLETED

Greenwood **KANSAS**Map No. 9 Sec. 17 Twp. 28 R. 11EWell No. 1 ShoemakerC. C. Whittaker ET/ Company

Contractor

FIRST REPORT

SECTION PLAT

NE NW NE

330 Ft. from N. Line Ft. from S. Line Ft. from E. Line990 Ft. from W. Line

		0	

Location Rig up

Drilling and Remarks:

10" - 385Dr1g. 450

RECORD

Cased in., ft.Sand Gas Oil Total Depth

PRODUCTION

1st 24 hrs. Nat. 1st 24 hrs. after shot Gas Cu. Ft.Dry Hole Abandoned

Date

JUN 1 - 1938 19

H. D. Hatfield

Scout

Greenwood **KANSAS**Map No. 9 Sec. 17 Twp. 28 R. 11EWell No. 1 ShoemakerC. C. Whittaker et al Company

Contractor

COMPLETED**NE NW NE**330 Ft. from N. Line Ft. from S. Line Ft. from E. Line990 Ft. from W. Line**SECTION PLAT**

		0	

Location Rig up

Drilling and Remarks:

RECORDCased 4 in. 1202 ft.Sand KC 1203Gas Oil Total Depth 1230**PRODUCTION**1st 24 hrs. Nat. 1st 24 hrs. after shot Gas Cu. Ft.Dry Hole Abandoned

Date

AUG 3 - 1938 19H. D. Hatfield

Scout