

KANSAS


Section 13 Township 16 Range 12-W

Well No. #6 Dollecheck "A"

Company Bradley Oil

Kraft-Prusa Pool

NORTH

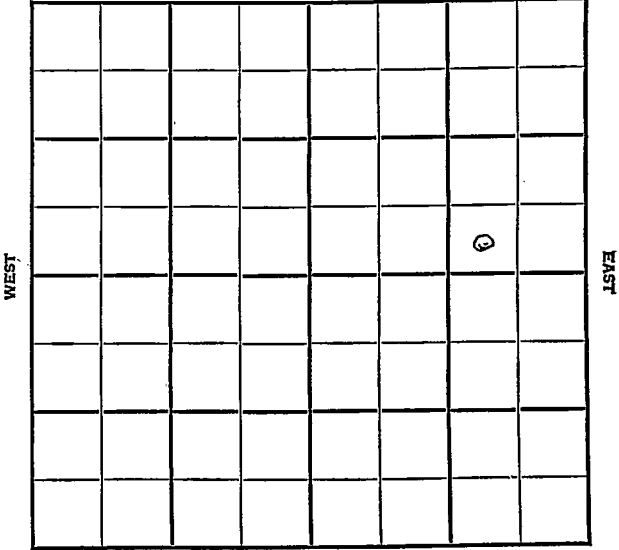

SOUTH



Sec. 13 Twp. 16 R. 12W

Well No. #6 Dolecheck "A" Farm

Bradley Oil Company

Kraft-Prusa Pool


Ft. from N. Line

330' Ft. from S. Line

990' Ft. from E. Line

Ft. from W. Line

SW SE NE

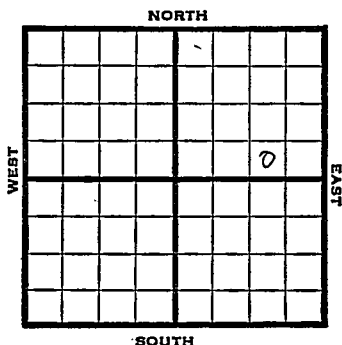

1948 Elev. 1890' REPORT

5/26 8" @ 224'
Lans. 3049'
Drlg. 3089'

6/1 Gorham 3312'
TD 3323'
5" @ 3321'
RUST

6/9 TD 3370
500' oil 12 hrs.

6/16 "

6/23 Swb 50 bbls oil a day

6/29 "

7/8 "

7/14 "

7/21 "

7/28 "

8/4 "

8/11 "

8/18 "

8/25 "

9/1 "

9/8 Gorham 3312'
5" @ 3321'
TD 3370'
Pump 50 oil Pot.
Gr. 42°

COMPLETED

Map No. _____ Sec. 13 Twp. 16 R. 12W

Well No. 6 Dolecheck "A"

Bradley Oil Company

FIRST REPORT Contractor

SW SE NE

SECTION PLAT

_____ Ft. from N. Line

330 Ft. from S. Line

990 Ft. from E. Line

_____ Ft. from W. Line

Barton County

Location _____

Rig up _____

Drilling and Remarks:

8" @ 224

Langs. 3049

drlg. 3089

RECORD

Cased _____ in., _____ ft.

Sand _____

Gas _____

Oil _____

Total Depth _____

PRODUCTION

1st 24 hrs. Nat. _____

1st 24 hrs. after shot _____

Gas _____ Cu. Ft.

Dry Hole _____

Abandoned _____

Date

MAY 26 1948 19

S. J. LEWIS Scout

