


Section 13 Township 16 Range 12W

Well No. #7, Dolecheck

Company R.E. Day

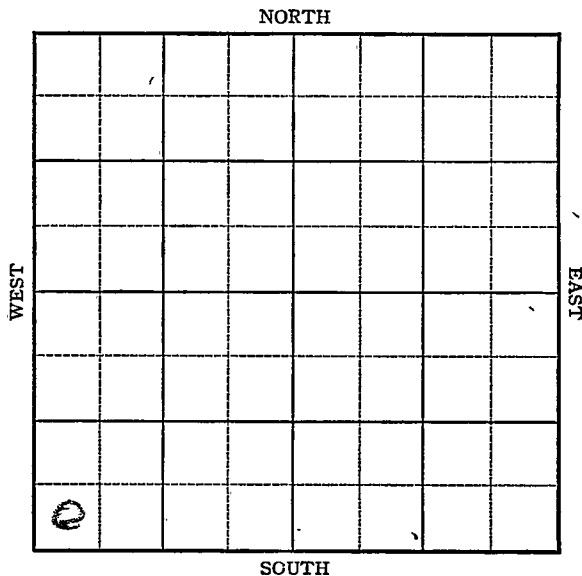

Sec. 13 Twp. 16 R. 12W

Well No. #7 Dolecheck Farm

R. E. Day Company

Kraft-Prusa


_____ Ft. from N. Line

330 Ft. from S. Line

_____ Ft. from E. Line

330 Ft. from W. Line

SW/c

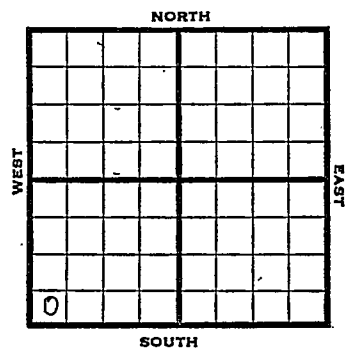

1946 Elev. 1902 REPORT

- 4/24 Location
- 5/1 Rig
- 5/7 Spud 50'
- 5/14 12" @ 350
Drlg 775'
- 5/21 Anhy 782,
10" @ 782
Drlg 1085'
- 5/29 8" @ 2140
Drlg. 2380'
- 6/5 Lans 3035
Run 7"
- 6/12 "
- 6/18 "
- 6/26 "
- 7/3 "
- 7/9 7" @ 3187 CO
- 7/16 " "
- 7/20 Arb 3337
5" @ 3338
TD 3342-1600' oil 6 hrs.
- 7/30 " " "

OVER

1946

8/7 Arb. 3337
5" @ 3338
1500 acid.
TD 3342'
Echo Pot. 3200
3000 Max.
Grav. 42.0

COMPLETED

KANSAS

KANSAS Pool Name Kraft-PrusaMap No. 55 Sec. 13 Twp. 16 R. 12WWell No. 7 DolecheckR. E. Day CompanyFIRST REPORT Contractor

SW/C

SECTION PLAT

 Ft. from N. Line330 Ft. from S. Line Ft. from E. Line330 Ft. from W. Line

o			

Barton County

Location XRig up

Drilling and Remarks:

RECORD

Cased in., ft.Sand Gas Oil Total Depth

PRODUCTION

1st 24 hrs. Nat. 1st 24 hrs. after shot Gas Cu. Ft.Dry Hole Abandoned

Date

APR 24 1946 19S. J. LEWIS Scout

KANSAS

Kansas

Pool Name Kraft-Prusa Pool

Map No. 55 Sec. 13 Twp. 16 R. 12W

Well No. 7 Dolecheck

R. E. Day Company

COMPLETED

Contractor

SW/C

E11902
SECTION PLAT

 Ft. from N. Line

330 Ft. from S. Line

 Ft. from E. Line

330 Ft. from W. Line

0			

Barton County

Location

Rig up

Drilling and Remarks:

Art 3337
5-10-3338
150 acid
Ech 100 3200
3000 Max
422 R/W

RECORD

Cased in, ft.

Sand

Gas

Oil

Total Depth 3342

PRODUCTION

1st 24 hrs. Nat.

1st 24 hrs. after shot

Gas Cu. Ft.

Dry Hole

Abandoned

Date

AUG 7 1946 19

S. J. LEWIS Scout