
Form 51—5M—7-39—Palace KANSAS

Barton

Section 13 Township 16 Range 12-W

Well No. #1 Hoffman

Company Black-Marshall Oil

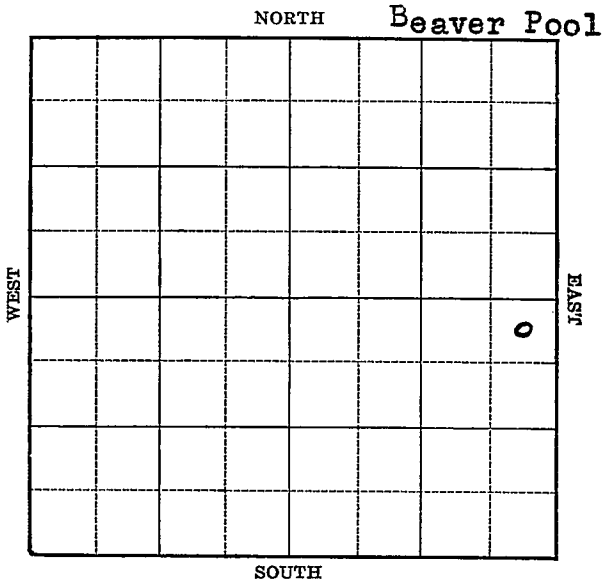

FORM 252-A 5M 2-40 KANSAS Barton

Sec. 13 Twp. 16 R. 12-W

Well No. #1 Hoffman Farm

Black - Marshall Oil Company


(Beaver)

330 Ft. from N. Line

Ft. from S. Line

440 Ft. from E. Line

Ft. from W. Line

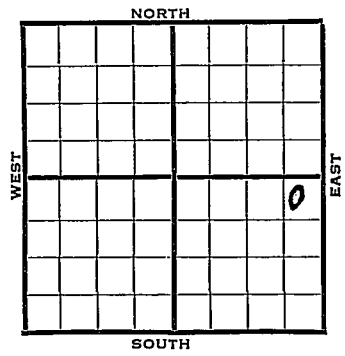

Elev. 1867

1940	REPORT
6/5	Cable.
	Spud 35'
6/13	12" - 282' Drlg. 655'
6/20	10" - 710' Drlg. 1550'
6/27	8" - 2050' Drlg. 2430'
7/3	8" - 2467' Drlg. 2515'
7/11	SD 3130'
7/18	Lans. 3010' 6" - 3113'
	S.O. 3185-90' Drlg. 3200'
7/25	Arb. 3301' Pay 3303-04' T.D.
	1000' oil 3¼ hours. 5" - 3302'
	WOC.
7/31	Arb. 3301'
	T.D. 3306'
	500 acid.
	Depthograph potential 3425 bbls.
	Maximum 3000 bbls.
	COMPLETED

Form 26—200 Bks.—1-40—Palace Barton KANSAS

Map No. 55 Sec. 13 Twp. 16 R. 12W

Well No. 1 Hoffman

Black - Marshall Oil Company

Contractor

FIRST REPORT

NE SE

330 Ft. from N. Line


Ft. from S. Line

440 Ft. from E. Line

Ft. from W. Line

BEAVER POOL

SECTION PLAT

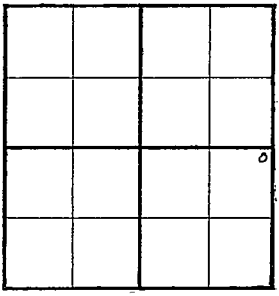

Location

Rig up

Drilling and Remarks:
Cable
S pud 35'

RECORD

Cased in., ft.

Sand

Gas

Oil

Total Depth

PRODUCTION

1st 24 hrs. Nat.

1st 24 hrs. after shot

Gas Cu. Ft.

Dry Hole

Abandoned

Date

JUN 5 1940 19

S. J. LEWIS Scout

Form 26—200 Bks.—1-40—Palace Barton KANSAS

Map No. 55 Sec. 13 Twp. 16 R. 12W

Well No. 1 Hoffman

Black-Marshall Oil Company

Contractor

COMPLETED

NE SE

330 Ft. from N. Line


Ft. from S. Line

440 Ft. from E. Line

Ft. from W. Line

BEAVER POOL

SECTION PLAT

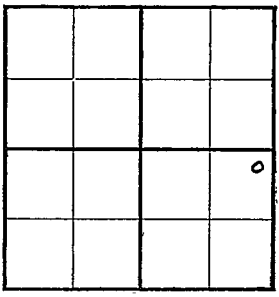

Location

Rig up

Drilling and Remarks:

500 acid

Depthograph Tot.

3425 bbls.

Mof 3000 bbls

RECORD

Cased in., ft.

Sand Buckle 3301

Gas

Oil

Total Depth 3306

PRODUCTION

1st 24 hrs. Nat.

1st 24 hrs. after shot

Gas Cu. Ft.

Dry Hole

Abandoned

Date

JUL 31 1940 19

S. J. LEWIS Scout