

KANSAS

Form 51—5M—7-39—Palace


Greenwood



Section 17 Township 28 Range 11-E

Well No. #1 West

Company Portzman & Snyder

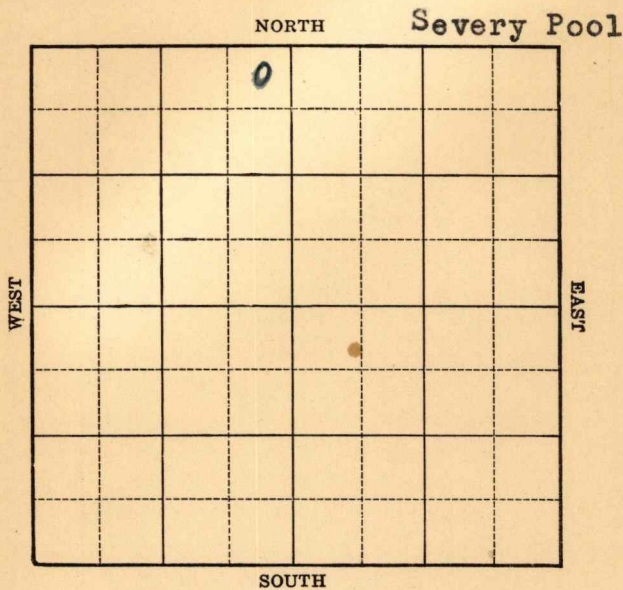

Sec. 17 Twp. 28 R. 11-E

Well No. #1 West Farm

Protzman & Snyder

Company


(Severy)

250 Ft. from N. Line

Ft. from S. Line

275 Ft. from E. Line

_____Ft. from W. Line

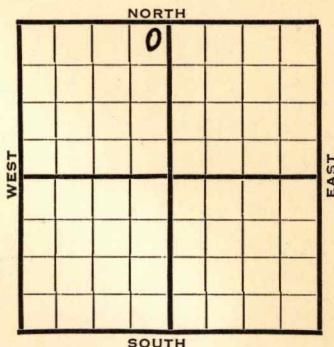

1940	REPORT
6/19	Spud
6/27	Drlg. 375'
7/3	Drlg. 540'
7/11	8" - 542' Drlg. 740'
7/18	6" - 1069' Lans. 1101'
	Drlg. 1103'
7/25	1200' ream 6".
8/2	1232' SD.
8/8	" "
8/14	6" - 1222' WOC
8/22	1245' SSO
8/29	T.D. 1245' P.B. 1241'
	2000 acid.
9/5	2 oil & 30 water per day.
9/12	Shut down.
9/19	" "
9/26	" "
10/3	" "
10/10	" "
10/17	" "
10/24	" "
10/31	" "

OVER

Map No. 9 Sec. 17 Twp. 28 R. 11EWell No. 1 WestProtzman & Snyder

Company

Contractor

FIRST REPORT

NE NW

250 Ft. from N. Line Ft. from S. Line275 Ft. from E. Line Ft. from W. Line

SECTION PLAT

		0	

SEVERY POOL

Location Rig up

Drilling and Remarks:

Spud

RECORD

Cased in., ft.Sand Gas Oil Total Depth

PRODUCTION

1st 24 hrs. Nat. 1st 24 hrs. after shot Gas Cu. Ft.Dry Hole Abandoned

Date

JUN 19 1940₁₉S. J. LEWIS Scout

Map No. 9 Sec. 17 Twp. 28 R. 11EWell No. 1 West

Protzman & Snyder

Company

Contractor

ABANDONED

NE NW

250 Ft. from N. Line Ft. from S. Line275 Ft. from E. Line Ft. from W. Line

NE NW

SECTION PLAT

		°	

Location Rig up

Drilling and Remarks:

*Lane 1101**6" @ 1232.**2000 acid**Water.*

RECORD

Cased in., ft.Sand Gas Oil Total Depth 1245

PRODUCTION

1st 24 hrs. Nat. 1st 24 hrs. after shot Gas Cu. Ft.Dry Hole Abandoned

Date

JAN 8 1941 19S. J. LEWIS

Scout

1940

11/7 6" - 1238'
T.D. 1242'

11/14 " "

11/21 " "

11/27 " "

12/5 " "

12/12 " "

12/19 Shut down.

12/26 " "

1941

1/2 Pump 2 bbls. per a day.
Shut down.

1/8 **Lans. 1101'**
6" - 1222'
T.D. 1245'
2000 acid.
Water.

ABANDONED