




Section 17 Township 28 Range 11-E

Well No. #2 Westbrook

Company C. Blankenship

NORTH Severy Pool

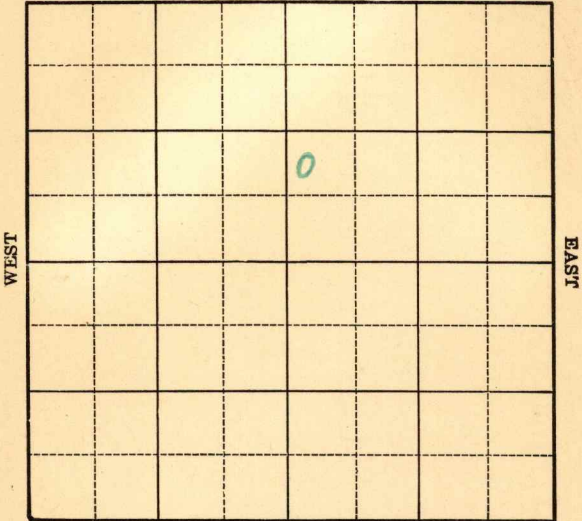

SOUTH





