




Section 17 Township 28 Range 11-E

Well No. 3 Westbrook

Company Blankenship

NORTH Severy Pool

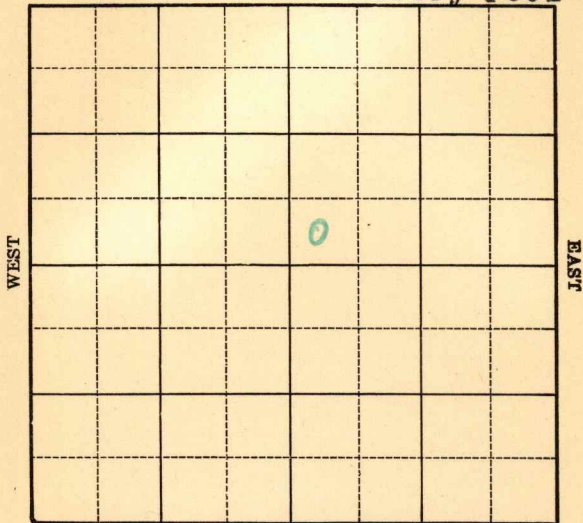

SOUTH

Sec. 17 Twp. 28 R. 11-E

Well No. #3 Westbrook Farm

Blanke nship Company


(Severy)

_____ Ft. from N. Line

330 Ft. from S. Line

_____ Ft. from E. Line

330 Ft. from W. Line

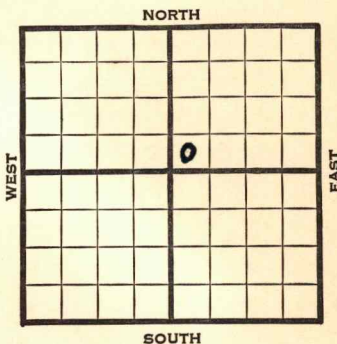

1941	REPORT
4/2	Machine - Spud.
4/10	Spud & SD.
4/18	Drlg. 250'
4/24	10" - 15' Drlg. 400'
5/1	8" - 848' K.C. 1108-16' T.D.
5/8	T.D. 1215' 6" - 1215' P.B.P.
5/15	T.D. 1223' P.B. to 1218'
5/22	Shut down.
5/27	K.C. 1108'
	6" - 1215'
	T.D. 1223'
	Pump 19 bbls.
	33. Gravity
	COMPLETED

Map No. 9 Sec. 17 Twp. 28 R. 11E

Well No. 3 Westbrook

Blankenship Company

FIRST REPORT Contractor

SECTION PLAT

SW NE

 Ft. from N. Line

330 Ft. from S. Line

 Ft. from E. Line

330 Ft. from W. Line

		o	

SEVERY POOL

Location

Rig up

Drilling and Remarks:

Machine Spud

RECORD

Cased in., ft.

Sand

Gas

Oil

Total Depth

PRODUCTION

1st 24 hrs. Nat.

1st 24 hrs. after shot

Gas Cu. Ft.

Dry Hole

Abandoned

Date

APR 2 1941 19

S. J. LEWIS Scout

Map No. 9 Sec. 17 Twp. 28 R. 11E

Well No. 3 Westbrook

Blankenship

Company

~~COMPLETED~~

Contractor

SW NE

SECTION PLAT

		o	

Ft. from N. Line

330 Ft. from S. Line

Ft. from E. Line

330 Ft. from W. Line

SEVERY POOL

Location _____

RECORD

Cased _____ in., _____ ft.

Sand _____

Gas _____

Oil _____

Total Depth 1223

Rig up _____

Drilling and Remarks:

KC1108

6" C/1215

Pump 1944

PRODUCTION

1st 24 hrs. Nat. _____

1st 24 hrs. after shot _____

Gas _____ Cu. Ft.

Dry Hole _____

Abandoned _____

330/95

Date

MAY 27 1941

19

S. J. LEWIS Scout