


Section 19 Township 25 Range 14E

Well No. 15 Akins

Company Bird-Hanley & Sheedy

Misc.

NORTH

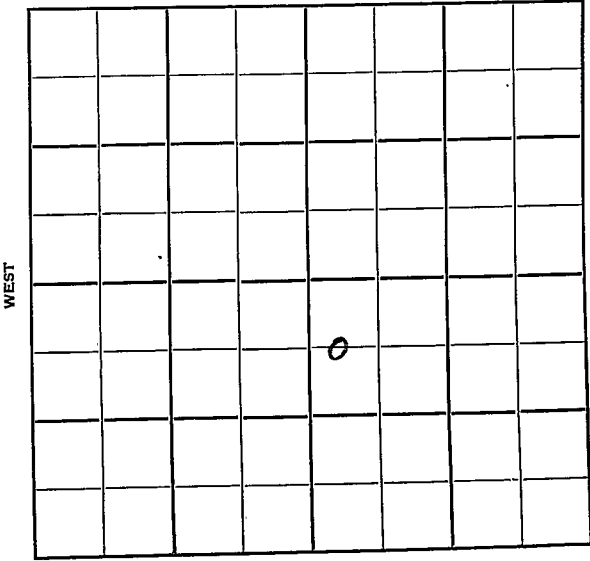

SOUTH

WEST

EAST

KANSAS

Woodson

Sec. 19 Twp. 25 R. 14E

Well No. #15 Akins Farm

Bird - Hanley & Sheedy Company

Miscellaneous


660' Ft. from N. Line

Ft. from S. Line

Ft. from E. Line

330' Ft. from W. Line

C W L NW SE

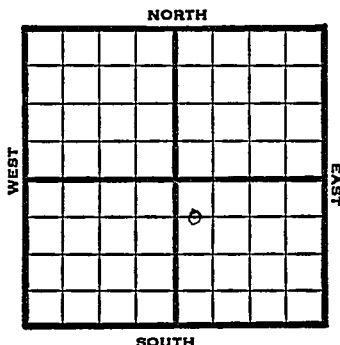

1949

REPORT

6/22

Bart 1395'
5" @ 1395'
TD 1445'
80 qts 20' off bottom
CO

6/29

TD 1445'
Bart 1395'
5 @ 1395'
80 qts
Pump 20 oil Pot
39⁶ Gr.
Comp

COMPLETED

Map No. _____ Sec. 19 Twp. 25 R. 14E

Well No. 15 Akins

Bird - Hanley & Sheedy Company

Contractor

C W L NW SE

FIRST SECTION PLAT
FIRST REPORT

660 Ft. from N. Line

_____ Ft. from S. Line

_____ Ft. from E. Line

330 Ft. from W. Line

		0'	

Woodson County

Location _____

Rig up _____

Drilling and Remarks:

Bart. 1395

5" @ 1395

TD 1445

80 qts. 20' off
bottom. cleaning
out

RECORD

Cased _____ in., _____ ft.

Sand _____

Gas _____

Oil _____

Total Depth _____

PRODUCTION

1st 24 hrs. Nat. _____

1st 24 hrs. after shot _____

Gas _____ Cu. Ft.

Dry Hole _____

Abandoned _____

Date

JUN 22 1949 19

S. J. LEWIS

Scout

Map No. K17 Sec. 19 Twp. 25 R. 14E

Well No. 15 Akins

Bird - Hanley & Sheedy Company
COMPLETE

Contractor

C W L NW SE

SECTION PLAT

660 Ft. from N. Line

_____ Ft. from S. Line

_____ Ft. from E. Line

330 Ft. from W. Line

		o	

Woodson County

Location _____

Rig up _____

Drilling and Remarks:

Bar X1395
5" @ 1395
809 to
Pump 20 oil BT
39' - 6"

RECORD

Cased _____ in., _____ ft.

Sand _____

Gas _____

Oil _____

Total Depth 1445

PRODUCTION

1st 24 hrs. Nat. _____

1st 24 hrs. after shot _____

Gas _____ Cu. Ft.

Dry Hole _____

Abandoned _____

Date

JUN 29 1949 19

S. J. LEWIS

Scout