

O. W. D. D

FORM 51 5M 11-44 PETROL


KANSAS

Barton

Section 13 Township 16 Range 12-W

Well No. #6 A. Hoffman (A)

Company ~~Black-Marshall~~ N.C.R.A.

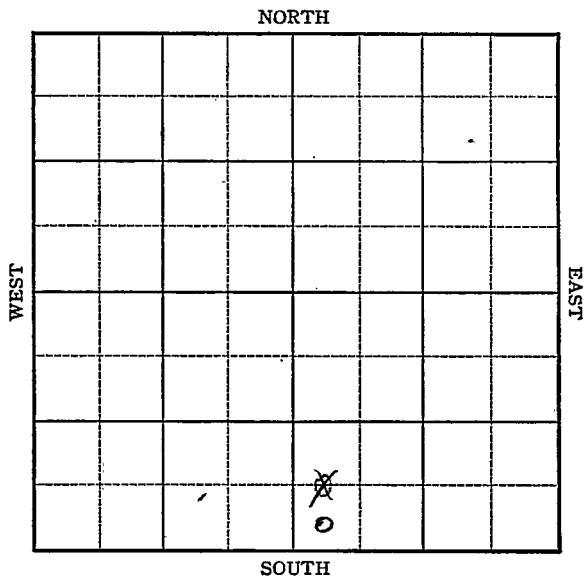


O. W. D. D. KANSAS

Barton County

Sec. 13 Twp. 16 R. 12WWell No. #6 A. Hoffman (A) FarmN. C. R. A.
Black-Marshal Company

Kraft-Prusa

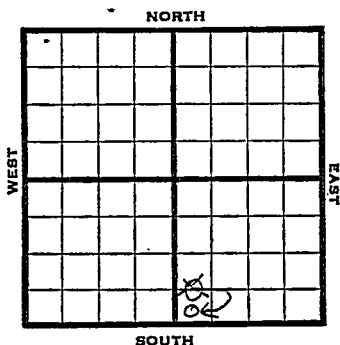 Ft. from N. Line330
660 Ft. from S. Line Ft. from E. Line330 Ft. from W. LineSW
CWE SW SE

1946 Elev. 1884' REPORT

1/16	Location
1/24	"
1/31	Rig.
2/7	R U R
2/14	"
2/21	12" - 475' 10" - 754'
	Drlg. 820'
2/28	Anhy 752' Drlg. 2055'
3/7	Drlg. 2490'
3/14	8" - 2059'
	Drlg. 2935'
3/21	Lans. 3055' B.K.C. 3309'
	Arb. 3318-20' T.D. SO
	5" - 3318' RUST.
3/27	Arb. 3318
	5" @ 3318
	TD 3323
	Pump 196 Pot.
	Grav. 42.0

COMPLETED

O. W. D. D

1952
8/6 Anhy 752' Lans. 3055' B KC 3309'
Arb. 3318' - prod. 5" @ 3318'
OTD 3323'
Drilling 3333' NS

OVER

1952

8/13

D&A TD 3373

Anhy 752

Lasn. 3055

B KC 3309

Arb. 3318

5" @ 3318 OTD 3323 DD 3337

wtr. inc. DD 3373 FU 1500' wtr.

S/ 30 bw tr. oil D&A

ABANDONED

KANSAS

Kansas

Pool Name Kraft-PrusaMap No. 53 Sec. 13 Twp. 16 R. 12WWell No. 6 A. HoffmanBlack-Marshall

Company

FIRST REPORT

Contractor

C W L SW SE

SECTION PLAT

		0	

Ft. from N. Line660Ft. from S. LineFt. from E. Line330Ft. from W. LineBarton CountyLocation .XRig up /

Drilling and Remarks:

RECORD

Cased in., ft.Sand Gas Oil Total Depth

PRODUCTION

1st 24 hrs. Nat. 1st 24 hrs. after shot Gas Cu. Ft.Dry Hole Abandoned

Date

JAN 16 194619S. J. LEWISScout

KANSAS

Kansas

Pool Name Kraft-PrusaMap No. 53 Sec. 13 Twp. 16 R. 12WWell No. 6 A. HoffmanBlack-Marshall

Company

CORRECTION

Contractor

SW SE

SECTION PLAT

 Ft. from N. Line330 Ft. from S. Line Ft. from E. Line330 Ft. from W. LineBarton CountyLocation Rig up

Drilling and Remarks:

reported

C W L SW SE

RECORD

Cased in., ft.Sand Gas Oil Total Depth

PRODUCTION

1st 24 hrs. Nat. 1st 24 hrs. after shot Gas Cu. Ft.Dry Hole Abandoned

Date

FEB 6 1946 19S. J. LEWIS Scout

KANSAS. Kansas Pool Name Kraft-Prusa
 Map No. 55 Sec. 13 Twp. 16 R. 12W
 Well No. 6 A. Hoffman

Black-Marshall

Company

COMPLETED

Contractor

SW SE


E. 1884
SECTION PLAT

 Ft. from N. Line

330 Ft. from S. Line

 Ft. from E. Line

330 Ft. from W. Line

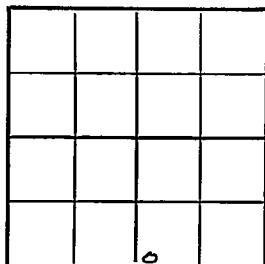

Barton County

Location

Rig up

Drilling and Remarks:

Core 8318.

5" @ 8318.

Pump 196 Bb.

420 Gr

RECORD

Cased in., ft.

Sand

Gas

Oil

Total Depth 2223

PRODUCTION

1st 24 hrs. Nat.

1st 24 hrs. after shot

Gas Cu. Ft.

Dry Hole

Abandoned

Date

MAR 27 1946

19

S. J. LEWIS

Scout

O. W. D. D

County Barton State KansasSec. 13 (Blk. Twp.) 16 (Sur. Rge.) 12W Map No.Operator N C R AWell No. 6 Farm Hoffman (A)Elev. 1884 Location SW SW SE330 Ft. From S Line SE330 Ft. From W Line Quarter1st. Report AUG 6 1952

Completion

Remarks OWDD

O. W. D. D

Spudding Date

Drig. Data

Anhy 752 Lans 3055 BKC 3309Arb 3318 - prod. 5" @ 3318 OTD 3323Drig. 3333 N.S.

J. G. McGEHEE

