


Section 19 Township 25 Range 14-E

Well No. #12, Aikins Est.

Company Bird-Hanely and Sheedy

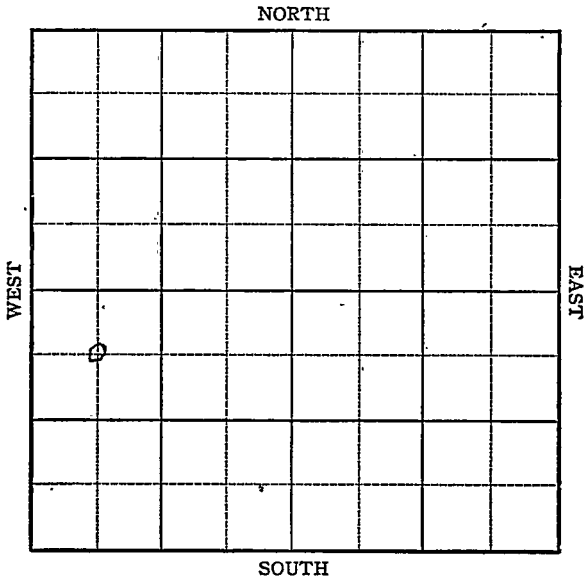


KANSAS

Woodson

Sec. 19 Twp. 25-1S R. 14-E
Well No. #12 Aikins Estate Farm
Bird-Hanley & Sheedy Company

660' Ft. from N. Line
 Ft. from S. Line
 Ft. from E. Line
660' Ft. from W. Line
C NW SW

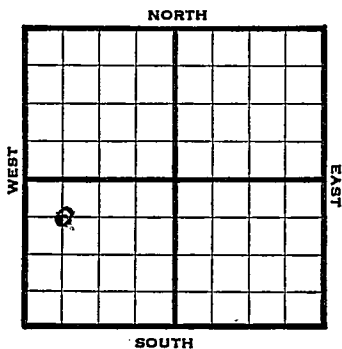

1946 REPORT

9/5 Bartl. 1420
1471 TD 1498
P B 1471
5" @ 1461
R U S T
9/10 " "
9/18 ?" "
9/25 Bart 1420'
5" @ 1421'
TD 1498'
180 qts 1425-1447'
POT 50 Pump
Grav 39

COMPLETED

KANSASKansas Pool Name MiscellaneousMap No. 17 Sec. 19 Twp. 25 R. 14EWell No. 12 Aikins Est.Bird-Hanley & Sheedy Company**FIRST REPORT**

Contractor

C NW SW

SECTION PLAT660 Ft. from N. Line Ft. from S. Line Ft. from E. Line660 Ft. from W. Line

0			

Woodson CountyLocation Rig up

Drilling and Remarks:

Bartl. 1420

1471 TD 1498

P B 1471

5" @ 1461

R U S T

RECORDCased in., ft.Sand Gas Oil Total Depth **PRODUCTION**1st 24 hrs. Nat. 1st 24 hrs. after shot Gas Cu. Ft.Dry Hole Abandoned

Date

SEP 5 1946 19S. J. LEWIS

Scout

KANSAS Kansas Pool Name Miscellaneous
 Map No. 17 Sec. 19 Twp. 25 R. 14E
 Well No. 12 Aikins Est.

Bird-Handley-Sheedy Company

COMPLETED

Contractor

C NW SW

SECTION PLAT

660 Ft. from N. Line

 Ft. from S. Line

 Ft. from E. Line

660 Ft. from W. Line

Woodson County

Location

Rig up

Drilling and Remarks:

Bar 1420
5' @ 1421
1809 to 1425-47
Bar 50 Bar 1425
392/36

RECORD

Cased in., ft.

Sand

Gas

Oil

Total Depth 1498 *1498*

PRODUCTION

1st 24 hrs. Nat.

1st 24 hrs. after shot

Gas Cu. Ft.

Dry Hole

Abandoned

Date

SEP 25 1946 19

S. J. LEWIS Scout