


Woodson

Section 13 Township 25 Range 13E

Well No. #1 Puckett

Company ~~Ed Ashlock~~ Pitcher Pump Co.

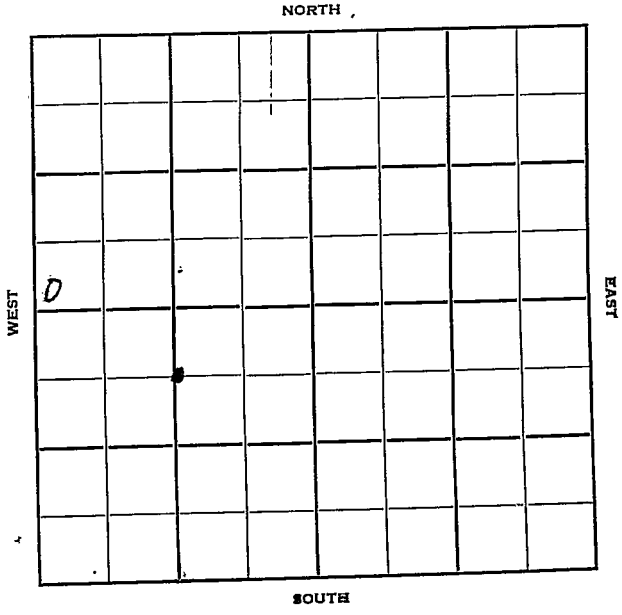

Woodson

KANSAS ✓

FORM 252-B

Sec. 13 Twp. 25 R. 13E

Well No. #1 Puckett Farm

Patcher Pump Co.
Ed Ashlock

Company

Ashlock - Contr.

Contractor


_____ Ft. from N. Line

330 Ft. from S. Line

_____ Ft. from E. Line

330 Ft. from W. Line

SW SW NW

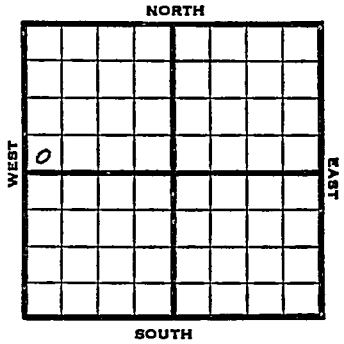

1953

Elev. -

REPORT

3/18

RUST

4/22

Spud 3-22-53

D&A

TD 1486

10" @ 120

8" @ 1040

TD 1486

D&A

ABANDONED

County Woodson State Kansas

Sec. 13 (Blk. Twp.) 25 (Sur. Rge.) 13E Map No.

Operator Ed Ashlock

Well No. 1 Farm Puckett

Elev. _____ Location SW SW NW

0					
FIRST REPORT					

330 Ft. From S Line NW

330 Ft. From 1st Line Quarter

Ist. Report MAR. 18 1953

Completion _____

Remarks _____

Ashlock - Contr.

Spudding Date _____

Drig. Data _____

RUST

Map No. _____ Sec. 13 Twp. 25 R. 13E

Well No. 1 Puckett

Pitcher Pump Co. Company

CORRECTION

Contractor

SW SW NW

SECTION PLAT

_____ Ft. from N. Line

330 Ft. from S. Line

_____ Ft. from E. Line

330 Ft. from W. Line

Woods on County

Location _____

Rig up _____

Drilling and Remarks:

Reported
Ed Ashlock

RECORD

Cased _____ in., _____ ft.

Sand _____

Gas _____

Oil _____

Total Depth _____

PRODUCTION

1st 24 hrs. Nat. _____

1st 24 hrs. after shot _____

Gas _____ Cu. Ft.

Dry Hole _____

Abandoned _____

Date

MAR 25 1953 19

J. G. McGEHEE Scout

County Woodson State Kansas

Sec. 13 (Blk. Twp.) 25 (Sur. Rge.) 13E Map No.

Operator Pitcher Pump Co.

Well No. 1 Farm Puckett

Elev. _____ Location SW SW NW

0					
ABANDONED					

330 Ft. From S Line NW

330 Ft. From W Line Quarter

1st. Report

Completion APR 22 1953

Remarks

Ashlock - Contr.

Spudding Date 3-22-53

Drlg. Data D & A TD 1486

10" @ 120 8" @ 1040 TD 1486

D & A