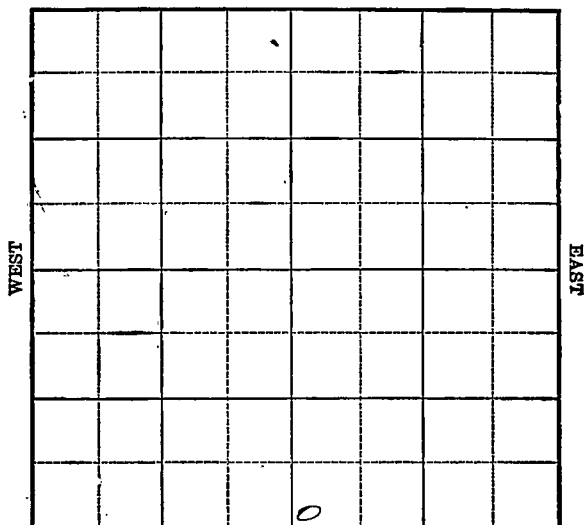


Well No. 1 Black Farm
Lassen et al Company

NORTH



SOUTH

Location _____

Drilling Remarks:

Rig Up _____

Drilling Remarks:

RECORD

Cased _____ in. _____ ft.

Sand _____

Gas _____

Oil_____

Total Depth_____

PRODUCTION

1st 24 hrs. Nat. _____

1st 24 hrs. after shot_____

Gas _____ cu. ft.

Dry Hole _____

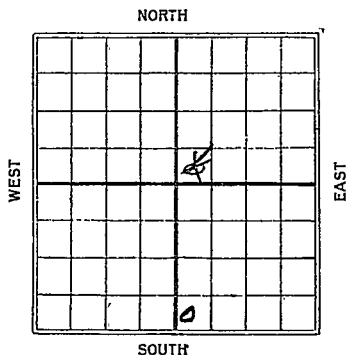
Abandoned_____

Map No. Kansas Sec. 14 Twp. 25 R. 13Well No. 1 Black Farm
Lassen et al Company

_____ Ft. from N. Line

200 Ft. from S. Line

_____ Ft. from E. Line

200 Ft. from W. Line

Date

REPORT

1925

3/1 Sand 1375-85 Spraying
Oil 4 M Gas

4/10 Sand 1375-85 4 M Gas
30-Bbb Shot 50 gts

Map No. *no map* Sec. *14* Twp. *25* R. *13*

Well No. *1 Black*

Lassen et al Company

Contractor

FIRST REPORT

SECTION PLAT

Completed
Ft. from N. Line

200 Ft. from S. Line

Ft. from E. Line

200 Ft. from W. Line

		o	

Location

Rig up

Drilling and Remarks:

*Sand 1375-85'
spraying air
4 mi gas.*

RECORD

Cased _____ in., _____ ft.

Sand _____

Gas _____

Oil _____

Total Depth _____

PRODUCTION

1st 24 hrs. Nat. _____

1st 24 hrs. after shot _____

Gas _____ Cu. Ft.

Dry Hole _____

Abandoned _____

Date

3/1 192 *5*

M. A. BENEAR Scout

Map No. 1500 Sec. 14 Twp. 25 R. 13Well No. 1 HulsonHulson & Co Company

Contractor

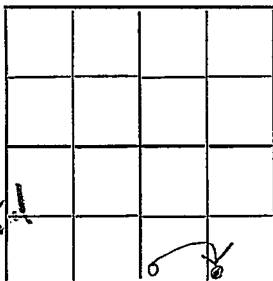
CORRECTION

SECTION PLAT

Ft. from N. Line

250 Ft. from S. Line1120 Ft. from E. Line

Ft. from W. Line

1st & Complete!

Location

Rig up

Drilling and Remarks:

50/30 bbls

RECORD

Cased 1375-25 in., 25 ft.Sand 4 14

Gas

Oil

Total Depth

PRODUCTION

1st 24 hrs. Nat.

1st 24 hrs. after shot

Gas Cu. Ft.

Dry Hole

Abandoned

Date

MAY 8 1925

192

CHAS. L. SHERWOOD

Scout

CORRECTION
 This well was completed
 April 7th. 1925.

chg location & then n

come to above.

Map No. 16ndth Sec. 14 Twp. 25 R. 13^E
 Well No. 1 BLACIS

LASSEN CH Company

Contractor

COMPLETED

SECTION PLAT

Ft. from N. Line

250

Ft. from S. Line

Ft. from E. Line

250

Ft. from W. Line

Location

Rig up

Drilling and Remarks:

shot 50 gts

30 bls

RECORD

Cased _____ in. _____ ft.

Sand 1375-85

Gas _____

Oil _____

Total Depth _____

PRODUCTION

1st 24 hrs. Nat. _____

1st 24 hrs. after shot _____

Gas 4 AA Cu. Ft.

Dry Hole _____

Abandoned _____

Date

APR 10 1925

192

Chs. L. Sheppard Scout