


Woodson

KANSAS ✓

Form 51-5M-11-31-Palace

Map No. _____ Sec. 14 Twp. 25 R. 13EWell No. 2-Bernard Farm _____Shedy et al Company _____

NORTH

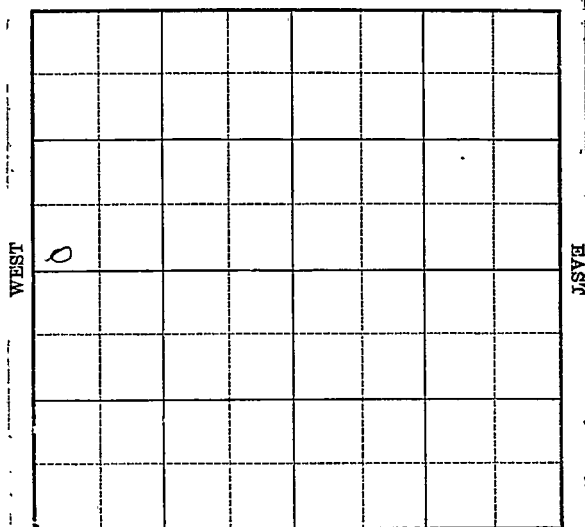

SOUTH

Location _____

Drilling Remarks _____

Rig Up _____

Drilling Remarks _____

RECORD

Cased _____ in. _____ ft.

Sand _____

Gas _____

Oil _____

Total Depth _____

PRODUCTION

1st 24 hrs. Nat. _____

1st 24 hrs. after shot _____

Gas _____ cu. ft.

Dry Hole _____

Abandoned _____

Map No. _____ Sec. 14 Twp. 25 R. 13E

Well No. 2 - Bernard Farm


Sheedy et al Company

_____ Ft. from N. Line

250 Ft. from S. Line

_____ Ft. from E. Line

250 Ft. from W. Line

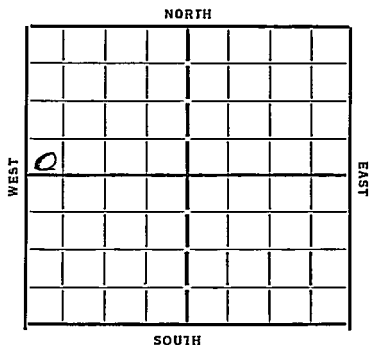

Date 7/33

REPORT

7/26 machine
8/12 drly 160'
8/19 10" 880'
8/17 sand 1489-96 show oil
8/23 —
8/30 sand 1520-33 - 1000' oil
9/6 Sand 1489-96
" 1520-33
60 gts 35 bbls

COMPLETED.

Watson
 Map No. *17* Sec. *14* Twp. *25* R. *13E*

Well No. *2 Bernard*

Shudy et al Company

Contractor


SECTION PLAT

_____ Ft. from N. Line

250 Ft. from S. Line

_____ Ft. from E. Line

250 Ft. from W. Line

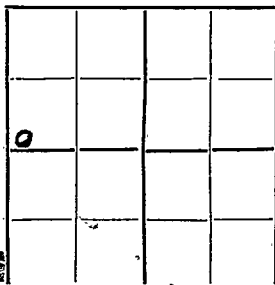

FIRST REPORTS

Location _____

Rig up _____

Drilling and Remarks:

Machine

RECORD

Cased _____ in., _____ ft.

Sand _____

Gas _____

Oil _____

Total Depth _____

PRODUCTION

1st 24 hrs. Nat. _____

1st 24 hrs. after shot _____

Gas _____ Cu. Ft.

Dry Hole _____

Abandoned _____

Date

7/26/33 192 *O. Menschick* Scout

Map No. 17 Sec. 14 Twp. 25 R. 13E
 Well No. 2-Bernard
Sheedy et al Company
 Contractor

SECTION PLAT

Ft. from N. Line

250 Ft. from S. Line

Ft. from E. Line

250 Ft. from W. Line

COMPLETED

Location.....

Rig up.....

Drilling and Remarks:

60 gts

35 lbs

RECORD

Cased.....in.,ft.

Sand 1489-96

Gas 1520-33

Oil.....

Total Depth 153.3

PRODUCTION

1st 24 hrs. Nat.

1st 24 hrs. after shot.....

Gas.....Cu. Ft.

Dry Hole.....

Abandoned.....

Date

9/6/33 O. Marmuchek Scout