


Map No. KANSAS Sec. 14 Twp. 25 R. 13E  
 Well No. 3-Mason Farm \_\_\_\_\_  
Chris. Cross Company \_\_\_\_\_

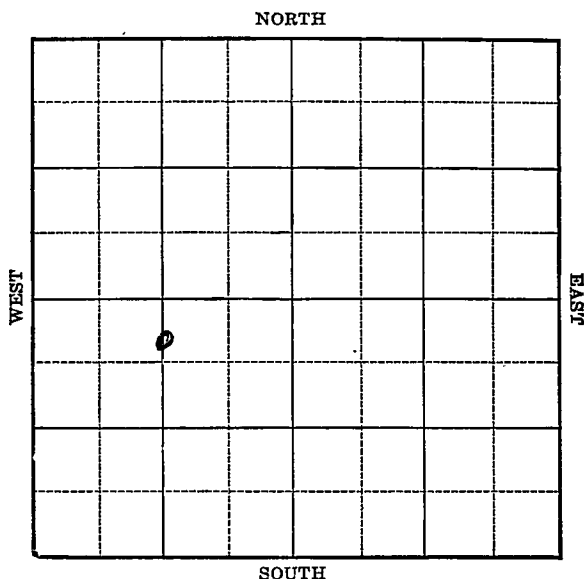

Location \_\_\_\_\_  
 Drilling Remarks \_\_\_\_\_

Rig Up \_\_\_\_\_  
 Drilling Remarks \_\_\_\_\_

**RECORD**

Cased \_\_\_\_\_ in. \_\_\_\_\_ ft.  
 Sand \_\_\_\_\_  
 Gas \_\_\_\_\_  
 Oil \_\_\_\_\_  
 Total Depth \_\_\_\_\_

**PRODUCTION**

1st 24 hrs. Nat. \_\_\_\_\_  
 1st 24 hrs. after shot \_\_\_\_\_  
 Gas \_\_\_\_\_ cu. ft. \_\_\_\_\_  
 Dry Hole \_\_\_\_\_  
 Abandoned \_\_\_\_\_

Woodson

Map No. KANSAS Sec. 14 Twp. 25 R. 13E


Well No. 3-Mason Farm  
Chas. Cross Company

500 Ft. from N. Line

\_\_\_\_\_ Ft. from S. Line

\_\_\_\_\_ Ft. from E. Line

1300 Ft. from W. Line

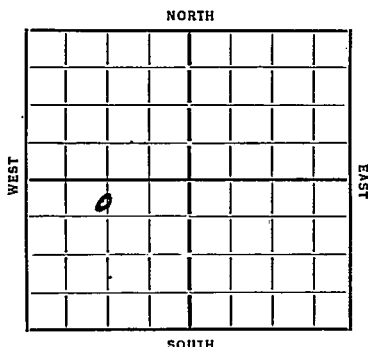

Date 1935

REPORT

4/10 Qty 660  
4/18 " 1300  
4/26 Bact A. 1455-73  
T 1491 400 oil  
5/1 Acid 1455-73  
T 1491  
Shot 30.95 20 Blk

COMPLETED

KANSAS

Map No. 17 Sec. 14 Twp. 25 R. 13EWell No. 3-Mason  
Chas Cross Company

Contractor

## FIRST REPORTS

500 Ft. from N. Line

Ft. from S. Line

Ft. from E. Line

1300 Ft. from W. Line

## SECTION PLAT

|  |  |  |  |
|--|--|--|--|
|  |  |  |  |
|  |  |  |  |
|  |  |  |  |
|  |  |  |  |
|  |  |  |  |
|  |  |  |  |

Location

Rig up

Drilling and Remarks:

Rel 660

## RECORD

Cased in, ft.

Sand

Gas

Oil

Total Depth

## PRODUCTION

1st 24 hrs. Nat.

1st 24 hrs. after shot

Gas Cu. Ft.

Dry Hole

Abandoned

Date

ORVAL MANNSCHRECK

4-10-35 192 Scout

Map No. 17 Sec. 14 Twp. 25 R. 13EWell No. 3-MasonChas Cross Company

Contractor

**COMPLETED**

## SECTION PLAT

500 Ft. from N. Line

.....Ft. from S. Line

.....Ft. from E. Line

1300 Ft. from W. Line

|   |  |  |  |
|---|--|--|--|
|   |  |  |  |
|   |  |  |  |
|   |  |  |  |
| 0 |  |  |  |
|   |  |  |  |

Location.....

Rig up.....

Drilling and Remarks:

30 gts20 lbs

## RECORD

Cased.....in., .....ft.

Sand 1455-73

Gas.....

Oil.....

Total Depth 1491

## PRODUCTION

1st 24 hrs. Nat.....

1st 24 hrs. after shot.....

Gas.....Cu. Ft.

Dry Hole.....

Abandoned.....

Date

5-1-35 192.....

ORVAL MANNSCHRECK

Scout